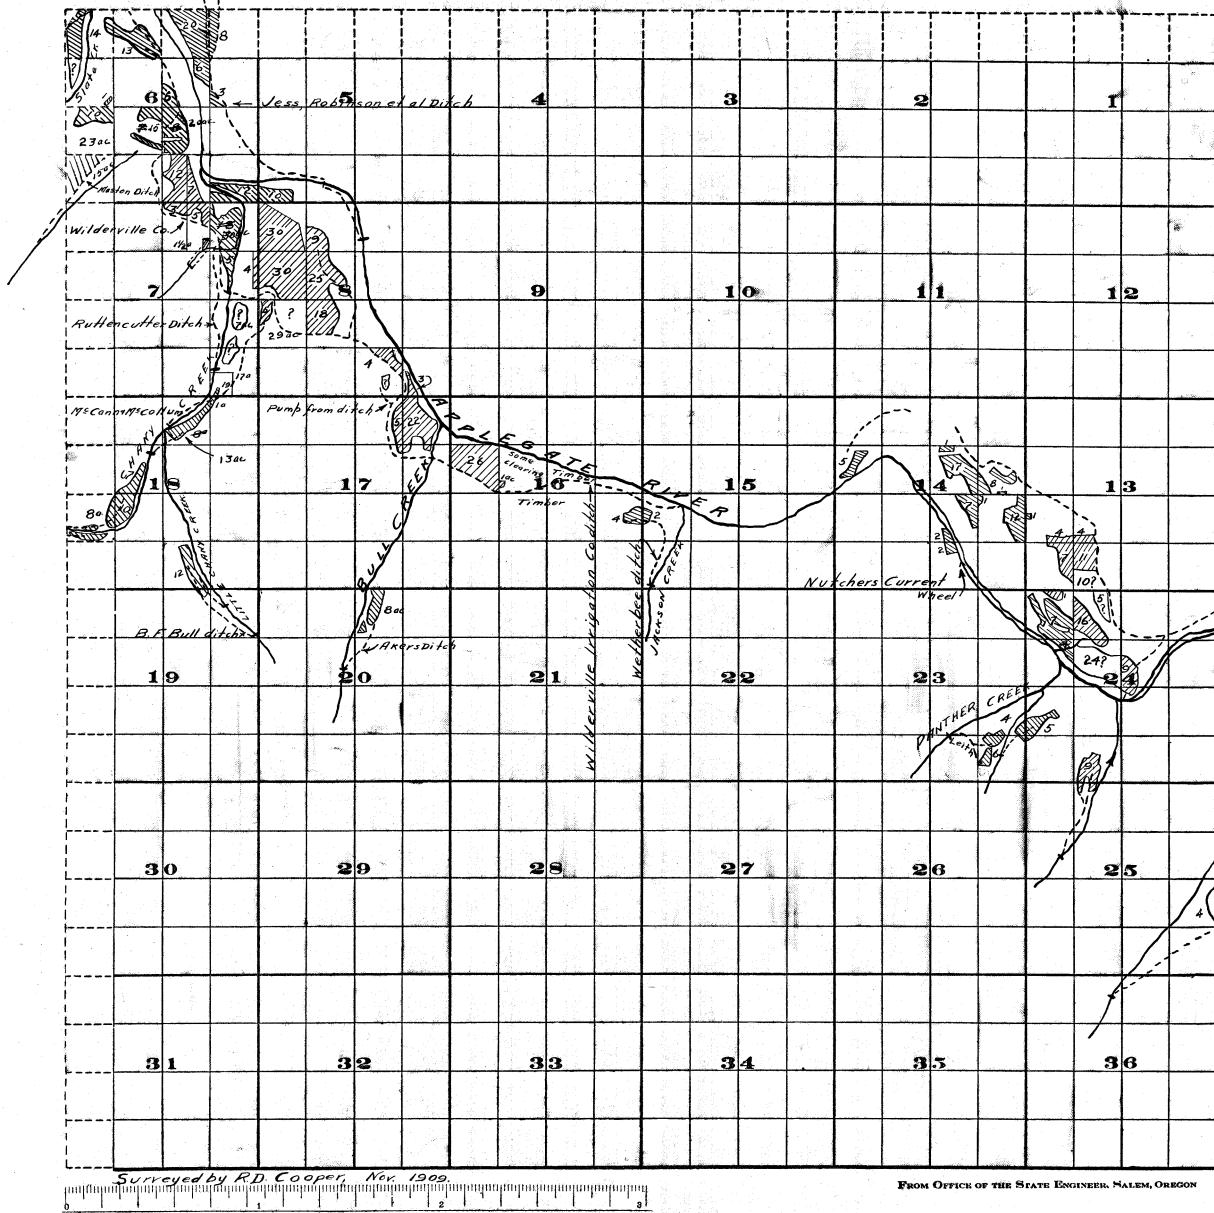


46-5-6

Township 375, Range 6W.

Adjudication


Rogue River and Tributaries
John H. Lewis State Engr.

Examined Sept. 18 1911

36

375. 6W.

43-5-6

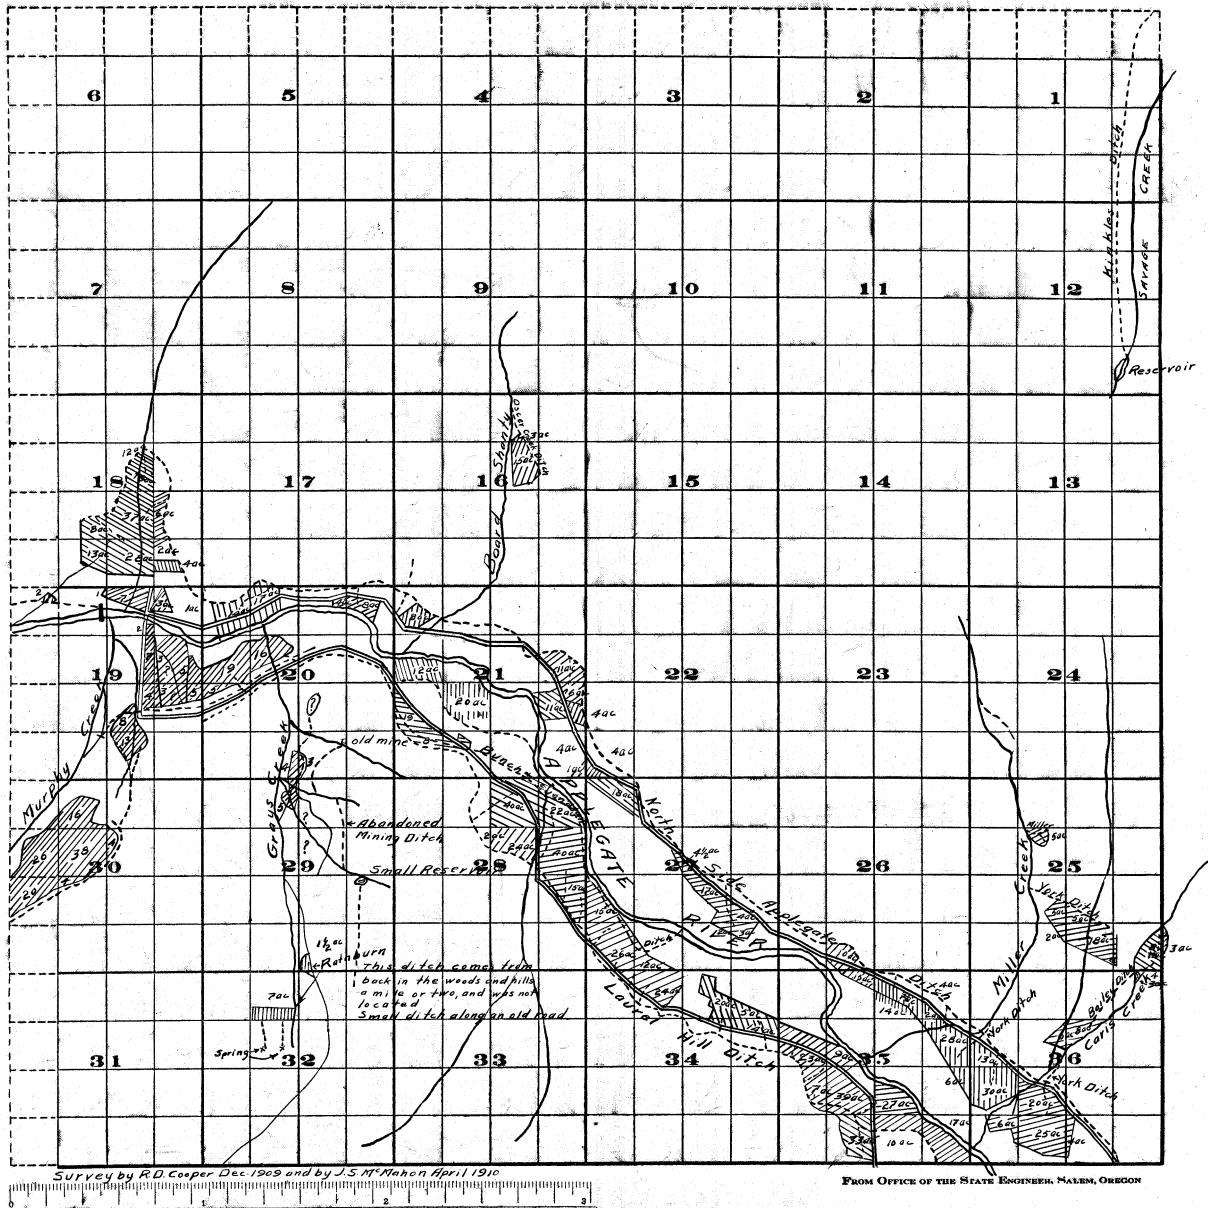Township 375, Range 5W.

Adjudication

Rogue River and Tributaries

Examined Sept. 18, 1911

John H. Lewis State Engr.

35.

375.5W.