

Request for Assignment

OREGON



Oregon Water Resources Department
725 Summer Street NE, Suite A
Salem, Oregon 97301-1266
(503) 986-0900
www.oregon.gov/owrd

If the Department determines that the application is incomplete, fees have not been paid, or the required documents are not acceptable, the application and all fees submitted will be returned to the applicant.

If for multiple rights, a separate form and fee for each right will be required.

1. David + Deborah Kelly Emma Kelly (deceased)
(Name of Current Holder of Record)
30 Bel Flora Rancho Santa Margarita, CA 92688 559-259-0238
(Mailing Address) (City) (State) (Zip) (Phone #)
bunkie93638@gmail.com
(Email Address)

- ☐ hereby assign all my interest in and to the entire application/permit/transfer order/limited license/groundwater statement; (Example, sold all the land authorized under the right)
- ☒ hereby assign all my interest in and to a portion of application/permit/transfer order/limited license/groundwater statement; (You must include a map showing the portion of the application/permit/transfer order/limited license/groundwater statement to be assigned. Example, sold a portion of the land authorized under the right)
- ☐ hereby assign a portion of my interest in and to the entire application/permit/transfer order/limited license/groundwater statement; (Example, adding an additional person)

Application # S-84136; Permit # S-53686; Transfer Order # _____;

Limited License # _____; Groundwater Statement # _____;

as filed in the office of the Water Resources Director, to:

Judy Rios & JAMES BOURQUIN
(Name of New Owner)
PO Box 369 Port Orford OR 97465 541-441-6450
(Mailing Address) (City) (State) (Zip) (Phone #)
riosjudy@hotmail.com
(Email Address)

Note: If there are other owners of the property described in the application, permit, transfer order, limited license, or groundwater statement, you must provide a list of all other owners' names and mailing addresses and attach it to this form. Write the initials (first letters) of your first and last names at the spot indicated below.

DKPK I hereby certify that I have notified all other owners of the property described in this application, permit, transfer order, limited license, or groundwater statement of this Request of Assignment.

Witness my hand this 3 day of December, 20 25
(Day) (Month) (Year)

Signature of Current Holder of Record

David Kelly Deborah Kelly
Emma (deceased)

Failure to provide any of the required information will result in the return of your application.

This certifies assignment and record change at Oregon Water Resources Department effective 8:00 a.m. on date of receipt at Salem, Oregon.

Fee receipt # 146480

For Director by Mary F. Bjork, Program Analyst in Water Rights Division. MFB

The completed "Request for Assignment" form must be submitted to the Department along with the recording fee of \$180.

Request for Assignment


WR

Received by OWRD

DEC 04 2025

Salem, OR

part assign - approve
MFB 12-5-2025

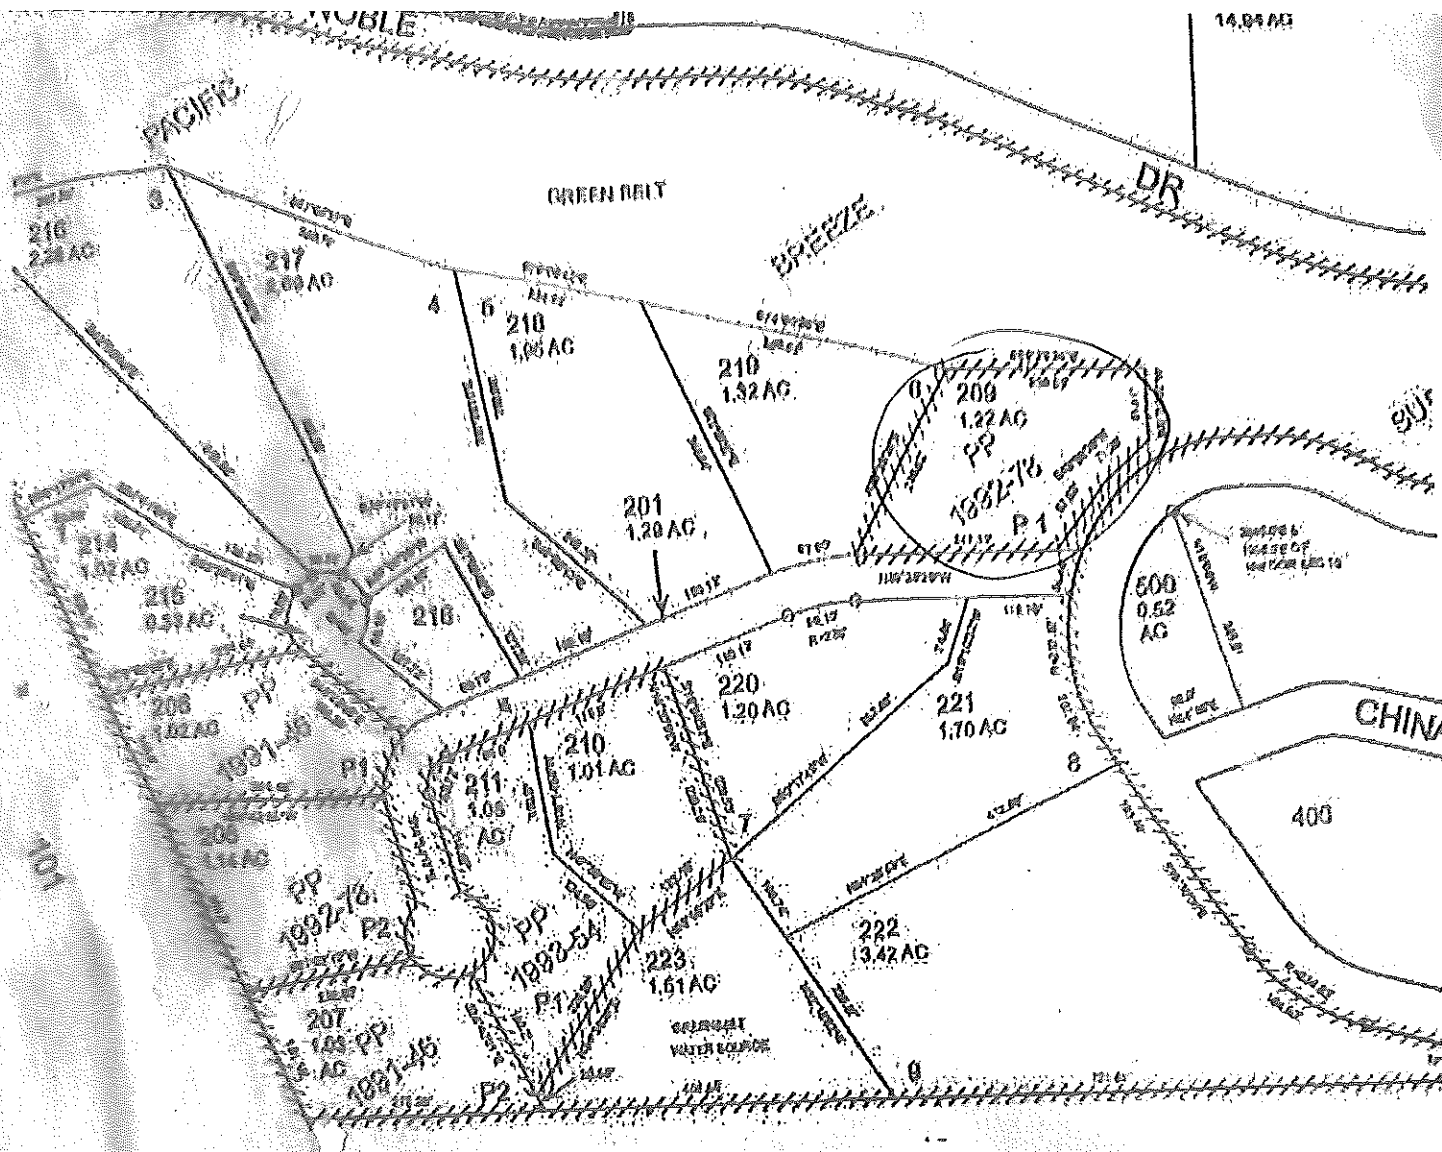

JUDITH RIOS
JAMES BOURQUIN

Received by OWRD
DEC 04 2021
Salem, OR



CURRY COUNTY TITLE
INSURANCE COMPANY
OF
CURRY COUNTY

THIS SKETCH IS PROVIDED, WITHOUT CHARGE, FOR YOUR INFORMATION. IT IS NOT INTENDED TO SHOW ALL MATTERS RELATED TO THE PROPERTY, INCLUDING BUT NOT LIMITED TO AREA, DIMENSIONS, EASEMENTS, ENCROACHMENTS OR LOCATIONS OF BOUNDARIES. IT IS NOT A PART OF, NOR DOES IT MODIFY, THE COMMITMENT OR POLICY TO WHICH IT IS ATTACHED. THE COMPANY ASSUMES NO LIABILITY FOR ANY MATTER RELATED TO THIS SKETCH, UNLESS SUCH COVERAGE IS SPECIFICALLY PROVIDED BY THE COVERED RISKS OF THE POLICY. REFERENCE SHOULD BE MADE TO AN ACCURATE SURVEY FOR FURTHER INFORMATION.