


Inset Map Detail

SENW

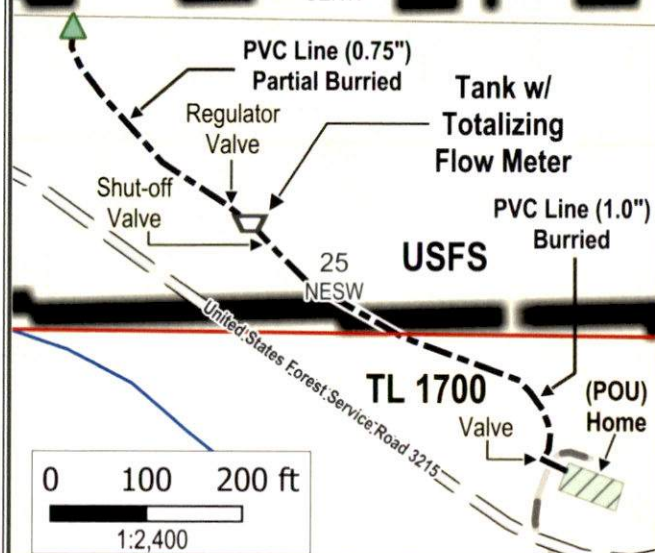


T. 14S, R. 10W, W.M. Section 25

POD Map Location:

GPS (decimal degrees): -123.850591, 44.322650 (+/- 10-ft)
West 1,140-ft, South 10-ft from the Center (Q's) for
Section 25; T. 14S, R. 10W, W.M.

SENW

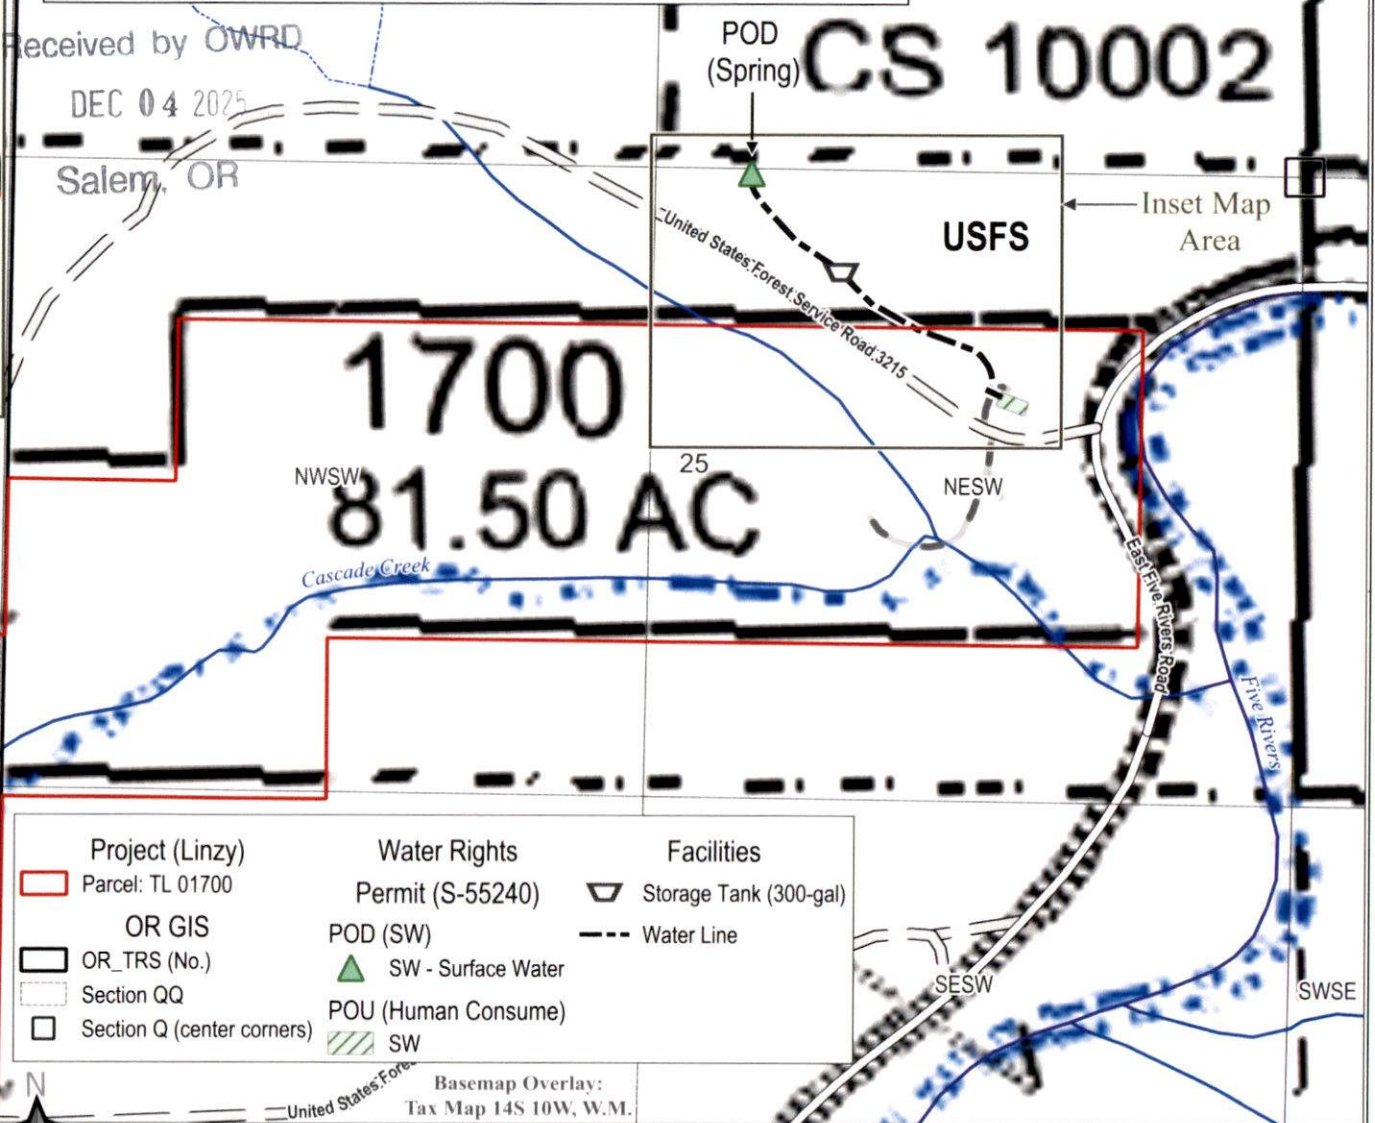

Certified Water Right Examiner
91134CWRE
Michael Higgins
MICHAEL HIGGINS
June 3, 2018
STATE OF OREGON
Expires: 6/30/27

Source:
Project CRS: EPSG: 6557 - NAD83(2011) / Oregon GIC Lambert (ft)
GIS Data: OR GeoHub, OWRD, Lincoln County

Prepared By: Michael Higgins, C.W.R.E.

Date: October 15, 2025

HGX Solutions, LLC

0 200 400 600 800 ft
1:4,800
Scale 1"=400' when printed at 8.5"x11.0" (Letter)

DISCLAIMER: This map is not intended to provide legal dimensions or locations of property ownership lines.

Claim of Beneficial Use Map for Application S 77639, Permit S 55240
In the Name of Darrell Linzy and Lewis Linzy
Tax Lot 01700, Tax Map 14 10 in Lincoln County, Oregon