

LOCATED IN
SECTION 31; T1N R10E W.M.
HOOD RIVER COUNTY, OREGON
CLAIM OF BENEFICIAL USE MAP


TAX LOT 802 APPLICATION G-16932
TAX MAP 01N 10E 31 PERMIT G-16381

CWRE STATEMENT
THIS MAP IS NOT INTENDED TO PROVIDE LEGAL DIMENSIONS OF
LOCATIONS OF PROPERTY OWNERSHIP LINES.

MAP INFORMATION
COORDINATE SYSTEM: STATE PLANE OREGON NORTH ZONE 3601
DATUM: NORTH AMERICAN DATUM OF 1983

DATA SOURCES
TAX LOT AND ROAD: HOOD RIVER COUNTY GIS
SECTION LINEWORK: HOOD RIVER COUNTY GIS


PREPARED FOR
CONFEDERATE TRIBES OF WARM SPRINGS
5620 RED HILL DRIVE
PARKDALE, OR 97041

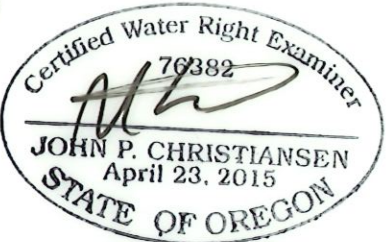

LEGEND

- TAX LOT BOUNDARY
- 1/4 1/4 SECTION LINE
- SECTION LINE
- WELL CONVEYANCE SYSTEM
- STREAM/RIVER
- POINT OF APPROPRIATION (POA)

WELL #5: 1458' NORTH AND 688' WEST FROM S 1/4 CORNER, SECTION 31
WELL #6: 1433' NORTH AND 823' WEST FROM S 1/4 CORNER, SECTION 31

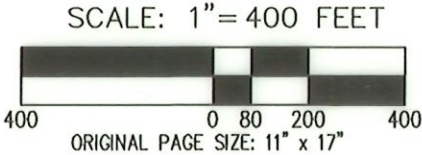


DATE: 09/10/2025

CLAIM OF BENEFICIAL USE MAP

PARKDALE FISH HATCHERY WATER RIGHTS
AKS ENGINEERING & FORESTRY, LLC
12965 SW HERMAN RD, STE 100
TUALATIN, OR 97062
503.563.6151 WWW.AKS-ENG.COM




EXHIBIT
A
DRWN: BGZ
CHKD: SRR
AKS JOB:
11393

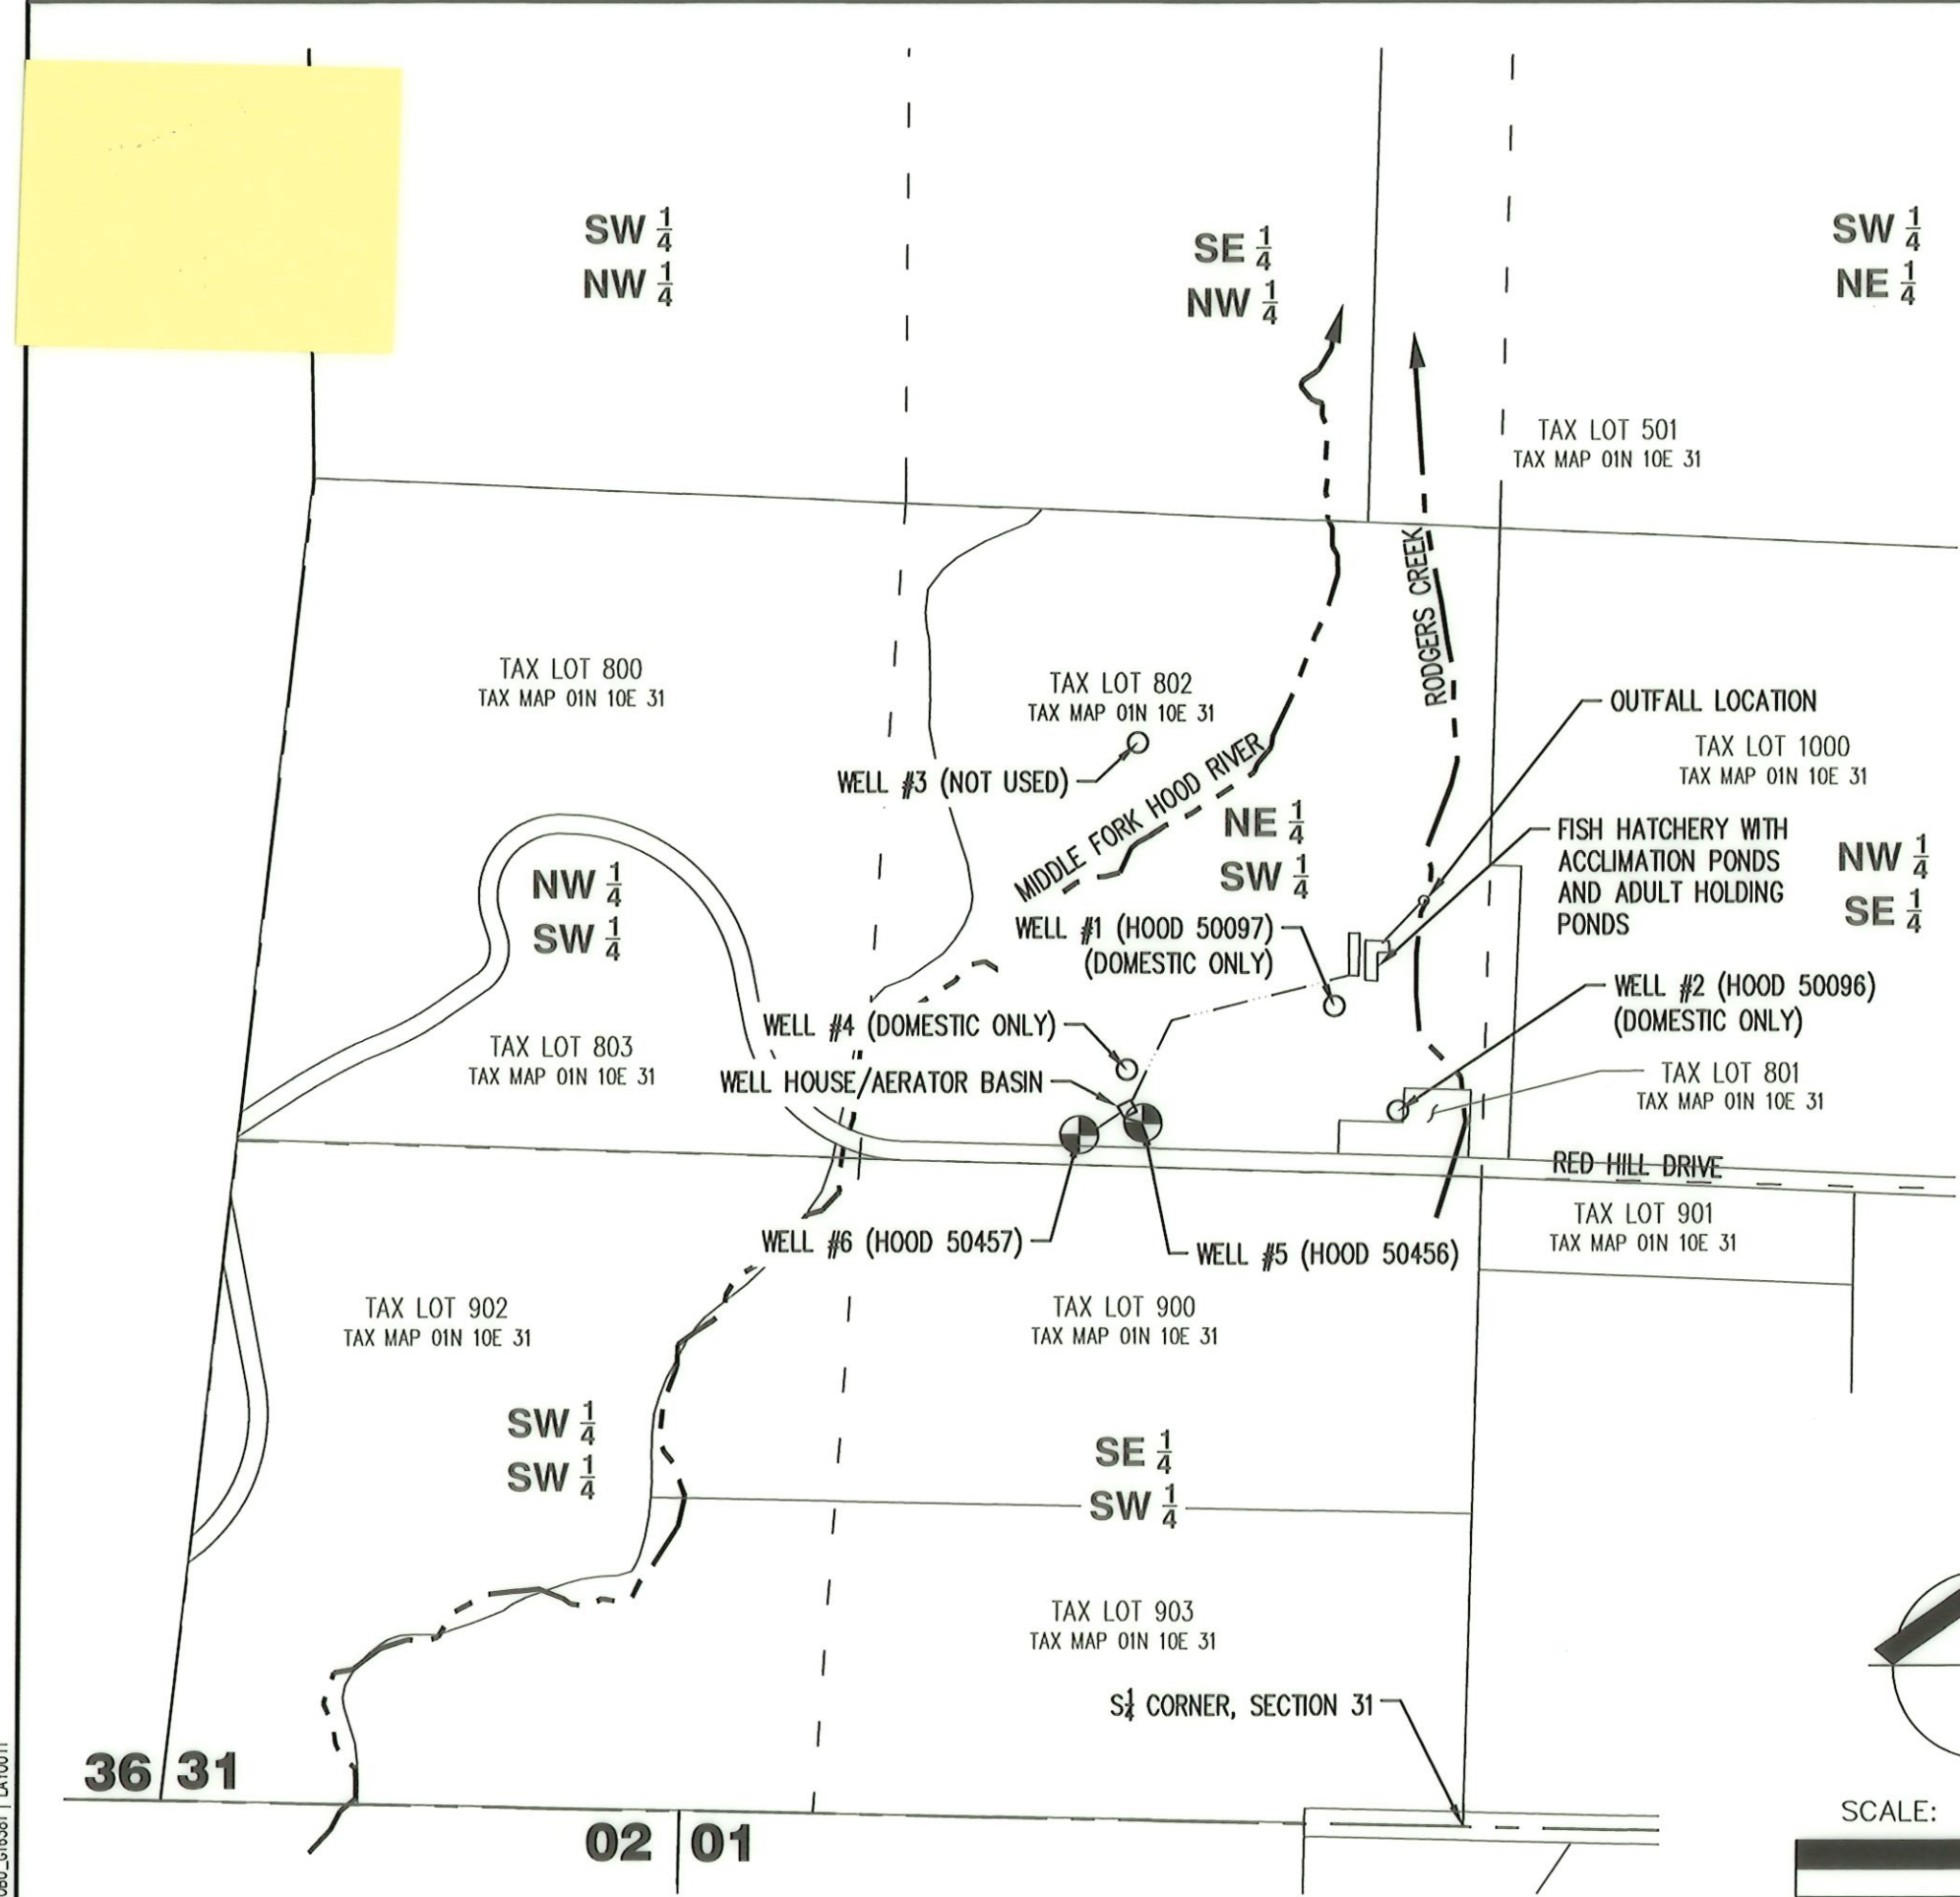

$1'' = 400'$

CANCELLED NO.
300
1001
1002
1003

Received
DEC 04 2025
OWRD

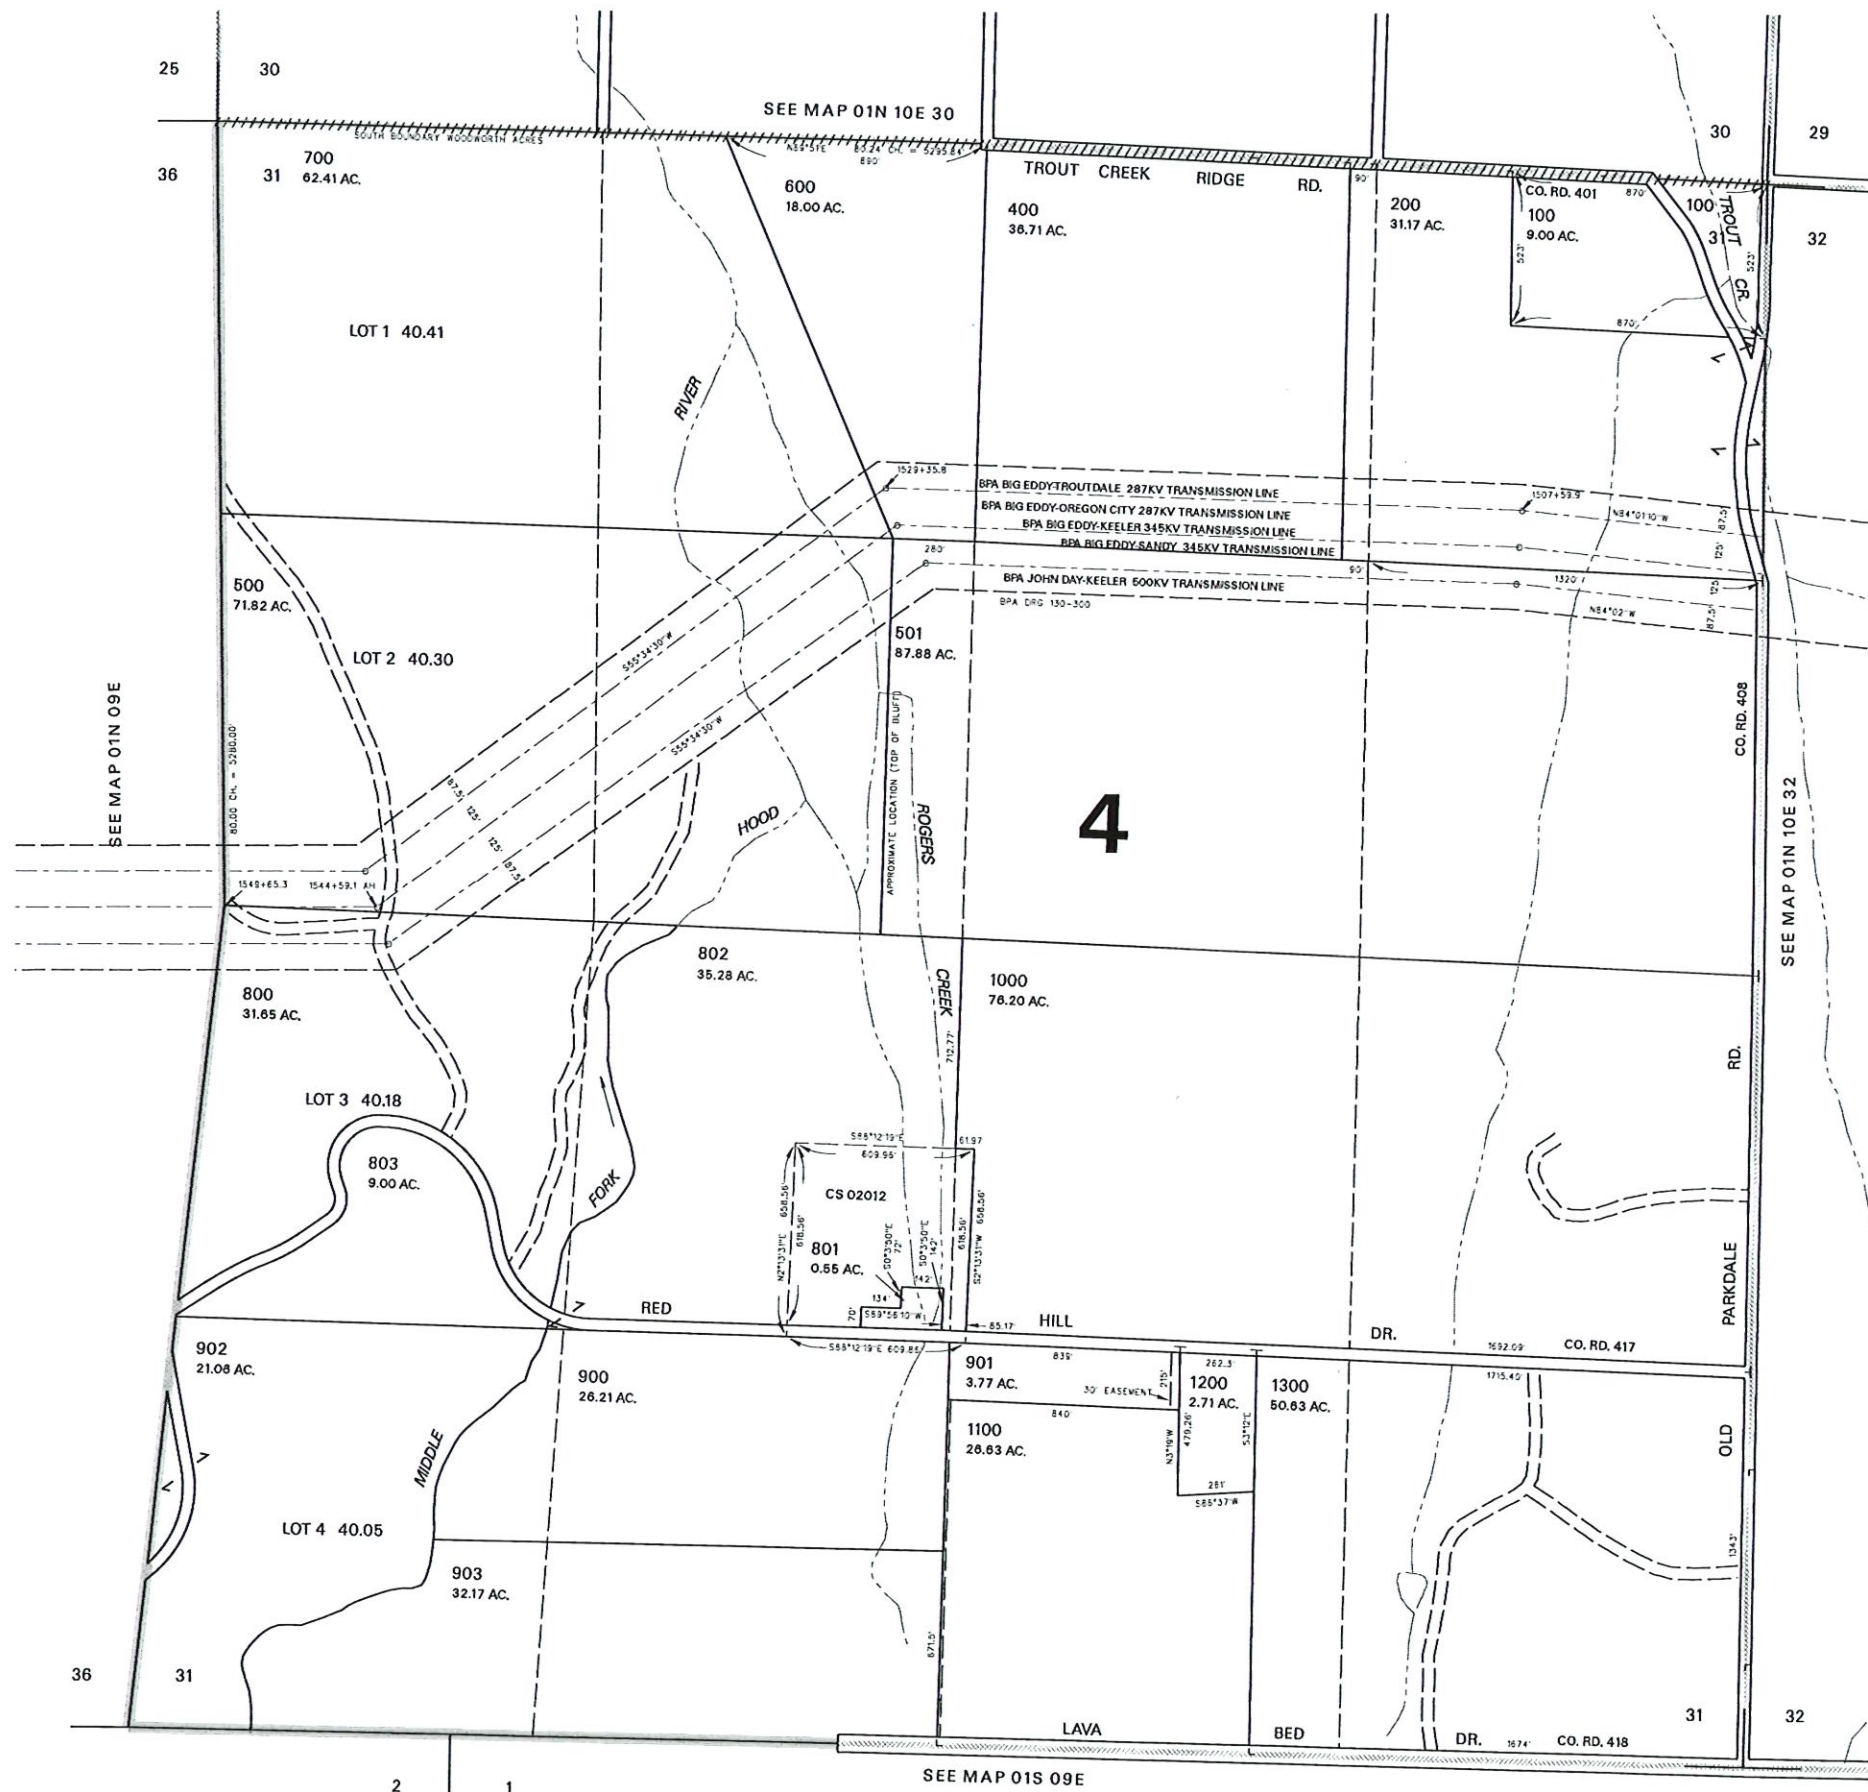

REVISED: JD
01/22/03

01N 10E 31