

FINAL PROOF MAP


FOR
COLUMBIA FOREST PRODUCTS

IN SECTION 18 T39S, R9E, W.M.
KLAMATH COUNTY, OREGON
APPLICATION No.: G-15196
PERMIT No.: G-14018

RECEIVED


JUN 04 2008

WATER RESOURCES DEPT
SALEM, OREGON

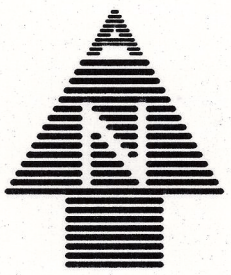

SCALE: 1" = 400'

GRAPHIC SCALE

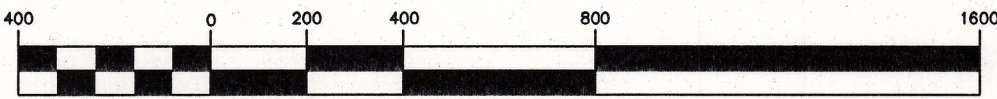

(IN FEET)
1 inch = 400 ft.



NOTES:

1. THIS MAP WAS PREPARED FROM FIELD MEASUREMENTS, NAIP 2005 AERIAL PHOTOGRAPH, TAX MAP 39 09 18, R.O.S. 893 AND OREGON GENERAL LAND OFFICE SURVEY PLATS.
2. THE PURPOSE OF THIS MAP IS TO IDENTIFY THE LOCATION OF THE WATER RIGHT ONLY, AND IS NOT INTENDED TO PROVIDE DIMENSIONS OR LOCATION OF PROPERTY LINES.

LEGEND

- 1300A1 TAX LOT NUMBER
- (1a) GOVERNMENT LOT NUMBER
- SW1/4 NW1/4 SECTION 1/4 1/4
- WATER DELIVERY SYSTEM
- ROADWAYS
- ++++ RAILROAD
- GOVERNMENT LOT LINE
- POWER LINE EASEMENT
- EDGE OF WATER
- 1/4 1/4 LINE
- SECTION LINES
- EXISTING STRUCTURE

Glen Kanan
Applicant signature

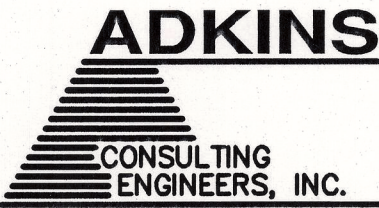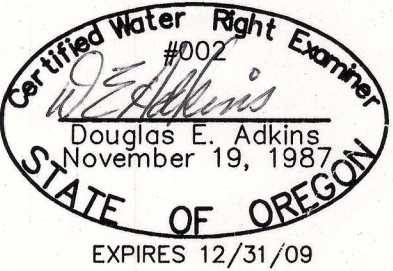

2950 Shasta Way · Klamath Falls, Oregon 97603 · (541) 884-4666 · FAX (541) 884-5335
Klamath Falls, OR · Medford, OR · Alturas, CA
APRIL 25, 2008 WR.DWG 2807-01

GOV'T LOT	TAX MAP NUMBER	1/4 1/4	SECTION	TOWNSHIP	RANGE	# ACRES
1a	1300 & 1300a1	SENE	18	39S	R9E, WM	26.2
9a	1300 & 1300a1	SENE	18	39S	R9E, WM	2.1

NOTE:
WELL #1 NOT DRILLED.
ALL WATER IS FROM WELL #2.

BOBU MAP # 0349