

## LEGEND

- Authorized Point of Appropriation (POA)
- Tank
- Meter
- Waterline


**Place of Use (POU)**

 Nursery - 1.5 acres

#### All Site - F-1

- Tax Lot
- Donation Land Survey (DLC)

**CERTIFIED WATER RIGHTS EXAMINER STAMP**

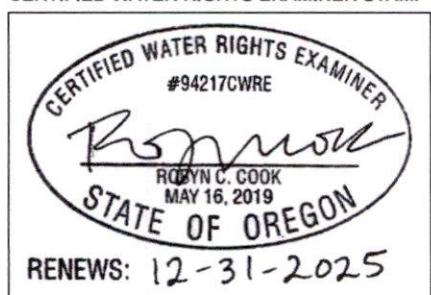

**LOCATION DESCRIPTION**

**LOCATION DESCRIPTION**  
**Well 1 (LINN 62629/L132107)**

## Claim of Beneficial Use Map

**Jack Hempicine, LLC**

**Application G-18831; Permit G-18529**

Benton County  
Township 10 South, Range 4 West (W.M.)

Received

DEC 08 2025

OWRD

## DISCLAIMER

This map was prepared for the purpose of identifying the location of a water right only and it is not intended to provide legal dimensions or location of property ownership lines.

Date: October 15, 2025  
Data Sources: BLM, ESRI, OWRD, USGS

2

1

166

GS

Water Solutions, Inc.

