
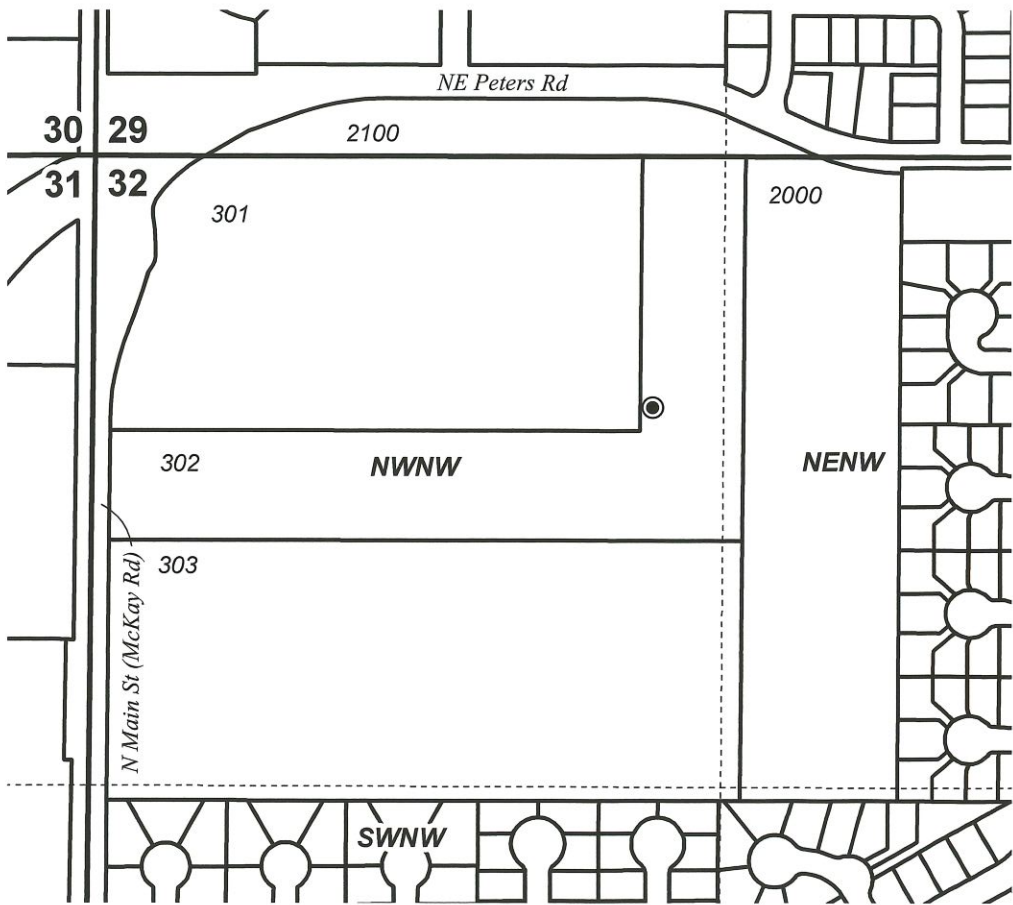


T14S R16E, WM
CROOK COUNTY, OR

- Well & Meter
— Section
----- Quarter Quarter
□ Tax Lot

East Well (CROO 1573) Location:
518.3' S, 1157.2' E of NW Cor Sec 32

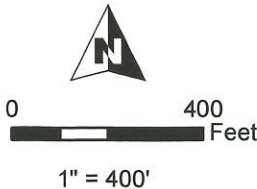

Received
DEC 11 2025
OWRD



CLAIM OF BENEFICIAL USE MAP
W SCOTT, LLC

This map is not intended
to provide legal dimensions
or locations of property
ownership lines.

WATER RIGHT SERVICES, LLC
PO BOX 1830, BEND, OR 97709
WWW.OREGONWATER.US CCB # 197121
johnshort@usa.com 541-389-2837

Date: 10/20/2025 T-10382