

LEGEND/NOTES:

— IRR — EXISTING UNDERGROUND 3" PVC PIPE



FINAL PLACE OF USE FOR IRRIGATION PER PERMIT NO. 54172, PRIORITY: MAY 13, 2004 (APPLICATION NO. S-86006) (2.0) ACRES IN NE1/4NE1/4

P.O.D. 1 FINAL POINT OF DIVERSION (WITH WATER METER AND FISH SCREEN) PER PERMIT NO. 54172 (APPLICATION NO. S-86006), 520'S AND 34'W OF THE NORTHEAST CORNER OF SECTION 17




EXISTING BUILDINGS

THE FINAL AREA OF USE SHOWN IS BASED UPON AN ON-SITE SURVEY CONDUCTED ON 10/8/2025.

THIS MAP IS NOT INTENDED TO PROVIDE LEGAL DIMENSIONS OR LOCATIONS OF PROPERTY OWNERSHIP LINES.

APPLICATION NO. S-86006
PERMIT NO. 54172

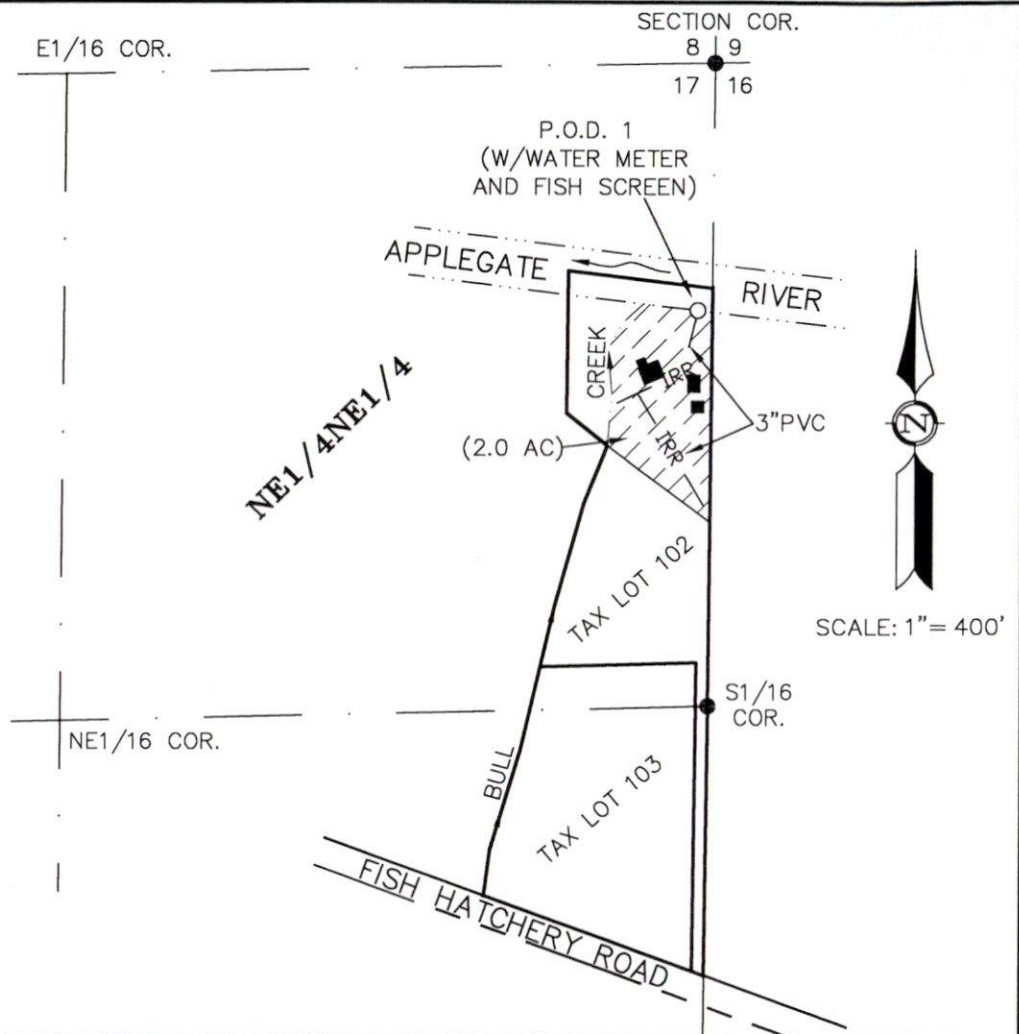


Received
DEC 11 2025

OWRD

Received
NOV 20 2025

OWRD

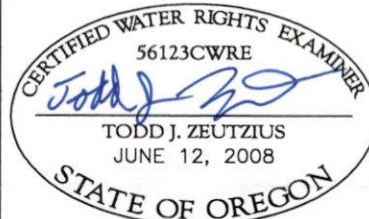

RENEWAL: JUNE 30, 2026

Allen Land Surveying, Inc.

321 N.W. "A" Street
Grants Pass, Oregon 97526
541-476-4502



CLAIM OF BENEFICIAL USE FOR PERMIT NO. 54172

LOCATED IN
Map No. 37-06-17, Tax Lots 102
NE1/4 of the NE1/4 of Section 17
T. 37 S., R. 6 W., W.M.
Josephine County, Oregon
SURVEY FOR

Cecil Cook

Grants Pass, Oregon

PROJECT NUMBER:
2025-057-1317
DRAWING FILE:
Cook-FishHatchCBU.dwg
DRAWING SCALE:
1" = 400'
DATE:
November 14, 2025
SHEET:
1 OF 1 (tz)