


Township 38S, Range 1E.

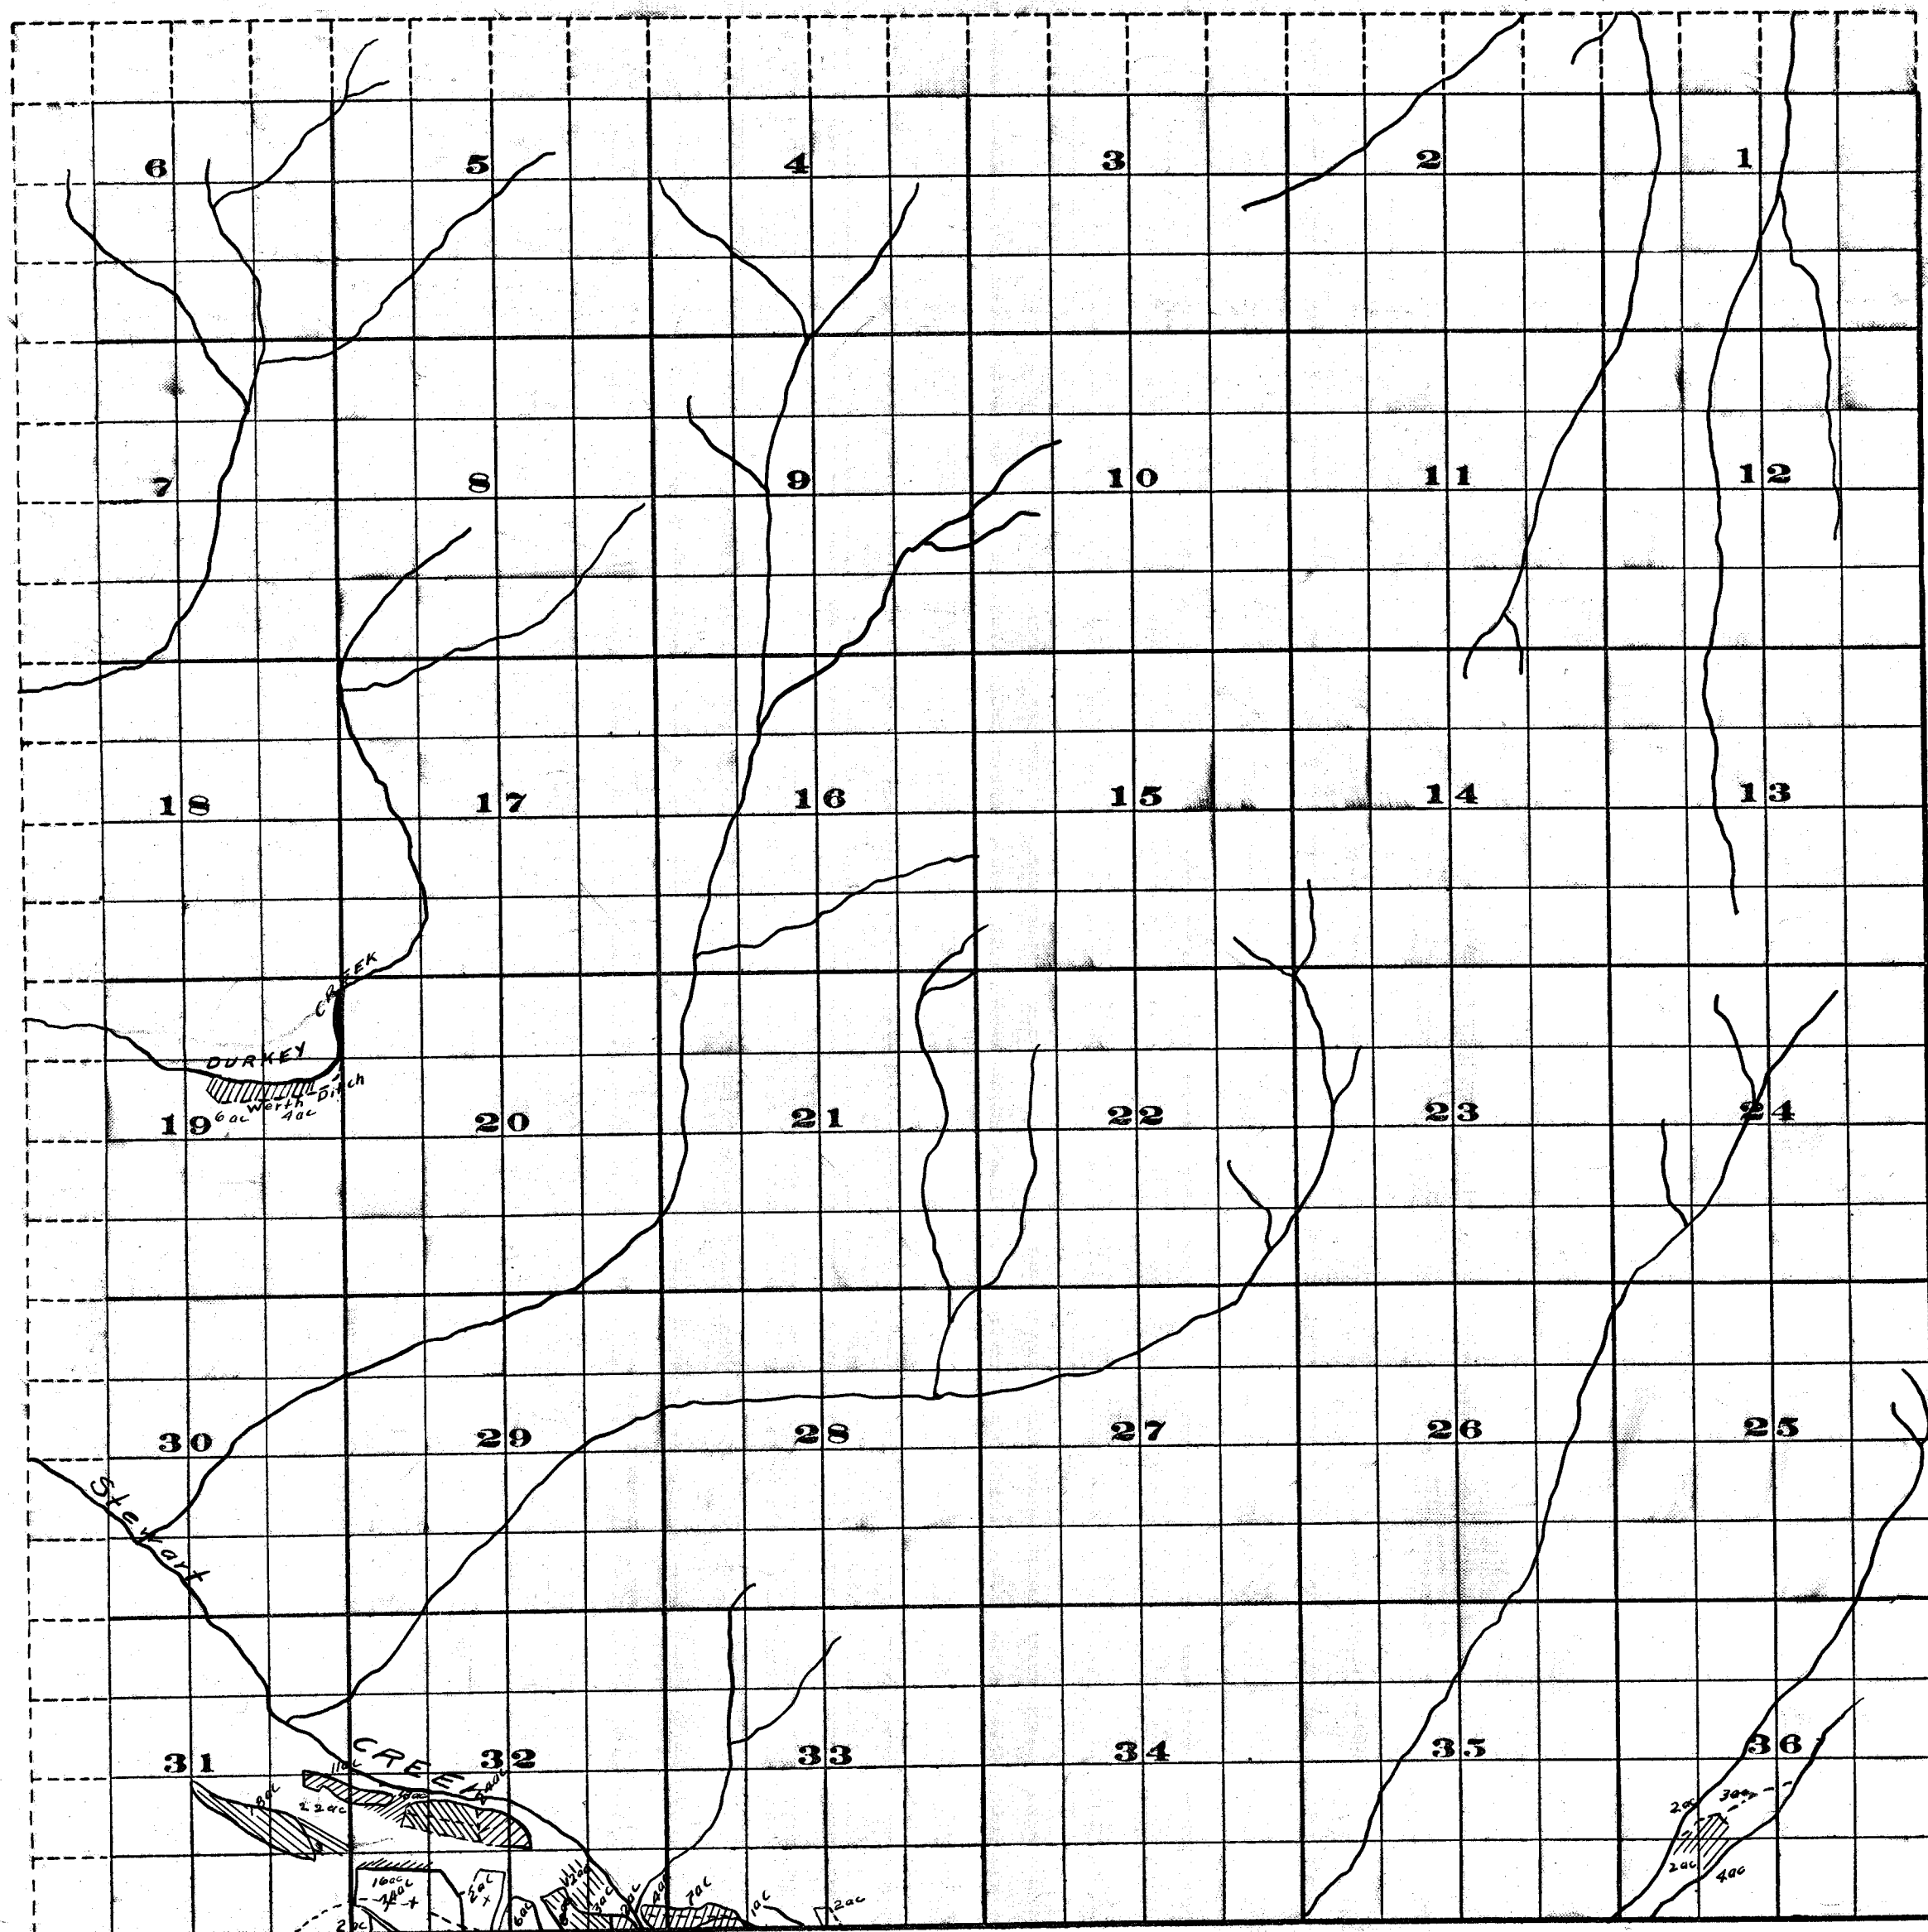

Survey by H.D. Farmer July 1911

FROM OFFICE OF THE STATE ENGINEER, SALEM, OREGON

M.D.
Q.E.M. 11/16-11

Scale of Feet.

Adjudication

Rogue River and Tributaries

John H. Lewis State Eng'r

Examined Sept. 18 1911.

38S. 1E.