
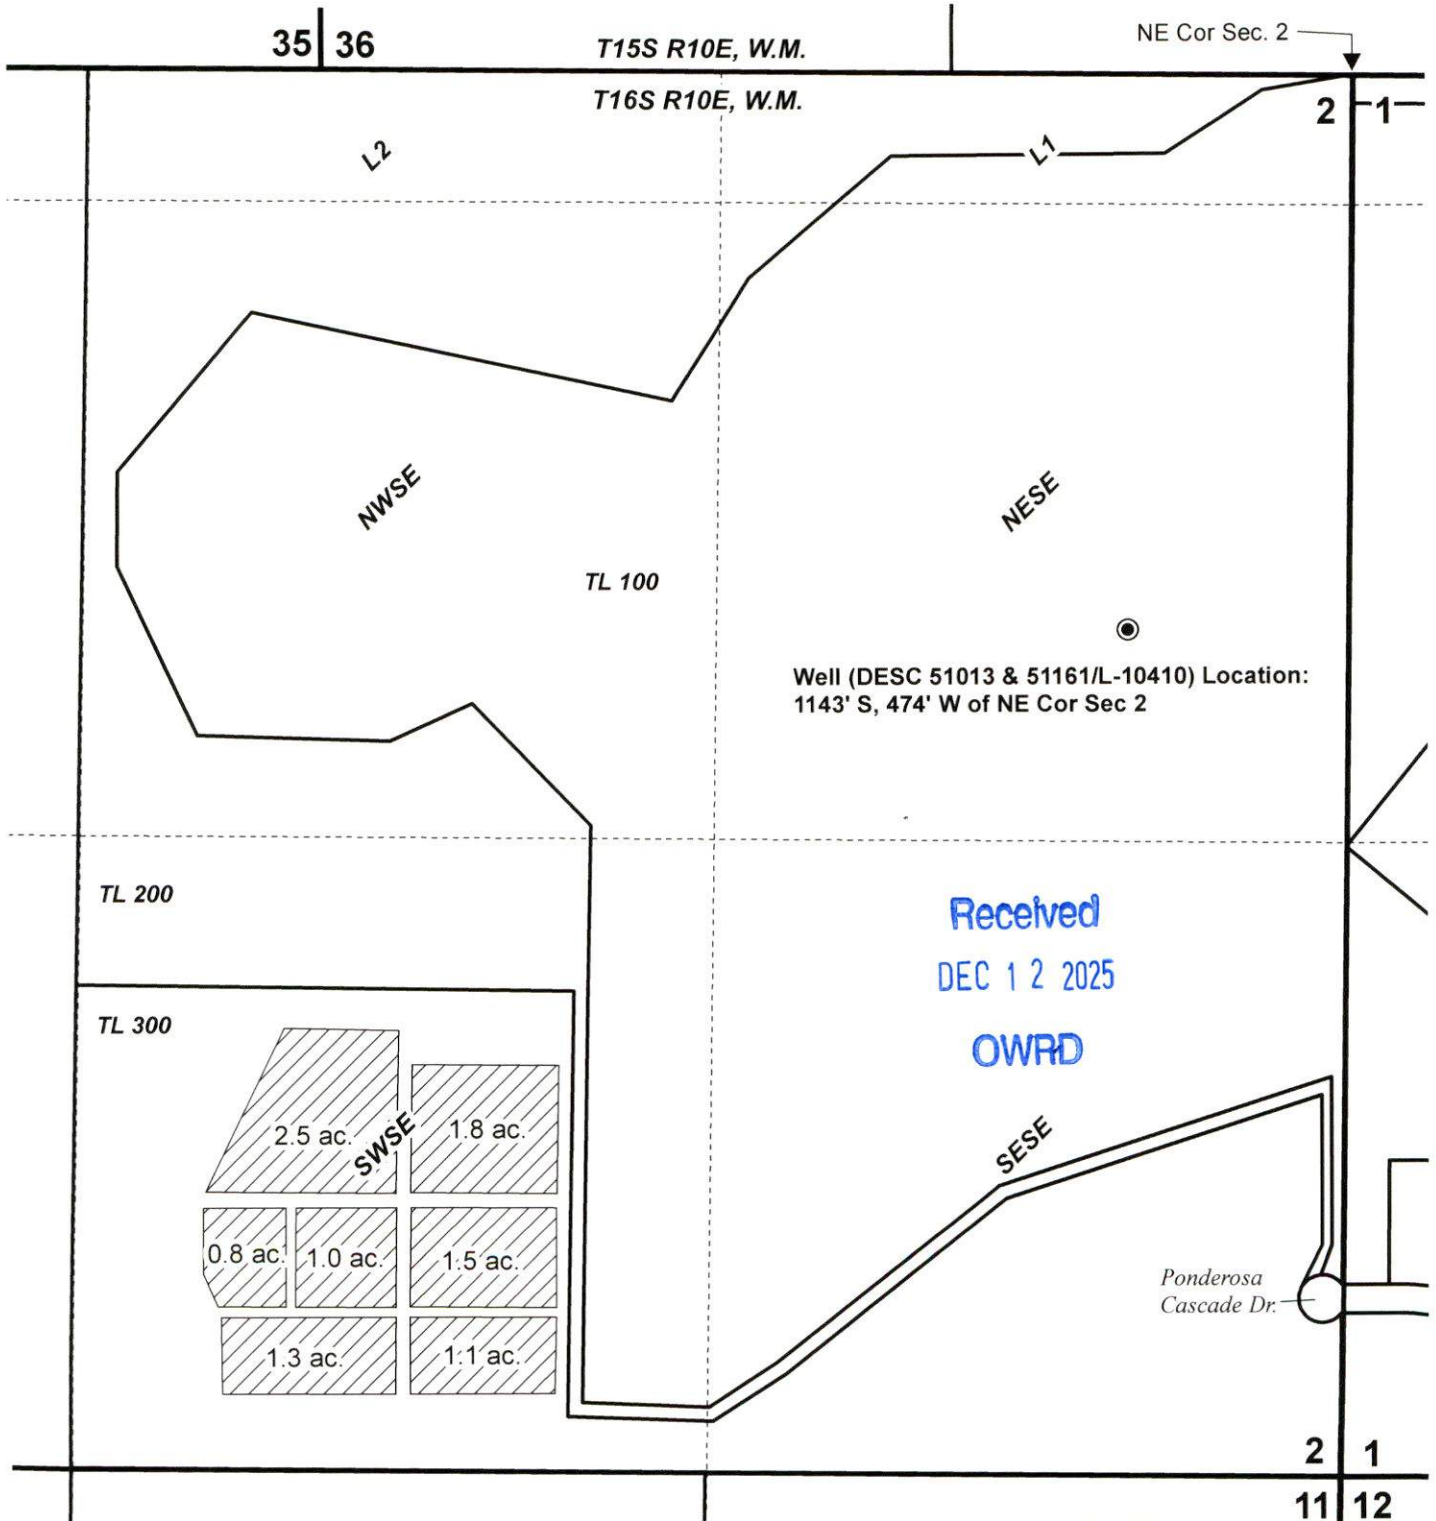


**T16S R10E, WM
DESCHUTES COUNTY, OR**

- Well
- Section
- - - Quarter Quarter
- Tax Lot
- ▨ POU IR 10/18/1994 Priority

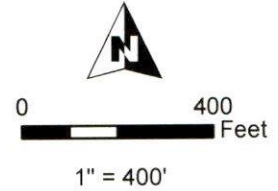

CLAIM OF BENEFICIAL USE MAP
Cowan

This map is not intended
to provide legal dimensions
or locations of property
ownership lines.

WATER RIGHT SERVICES, LLC
PO BOX 1830, BEND, OR 97709
WWW.OREGONWATER.US CCB # 197121
brycewrs@gmail.com 541-389-2837

Date: 9/24/2025

T-13078