


T15S R14E, WM CROOK COUNTY, OR

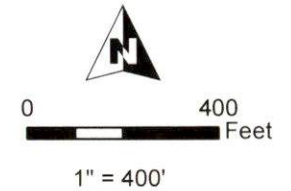

● Additional Point of Diversion, Meter

■ Existing POD/Meter

--- Dry River (Old River Bed)

Place of Use

Section

--- Quarter Quarter


Tax Lot

APOD #1:
600' S, 300' E OF NW COR SEC 11

Authorized POD Location:
SENE QQ SEC 11, T15S, R14E, W.M.



RENEWS: 06/30/2026

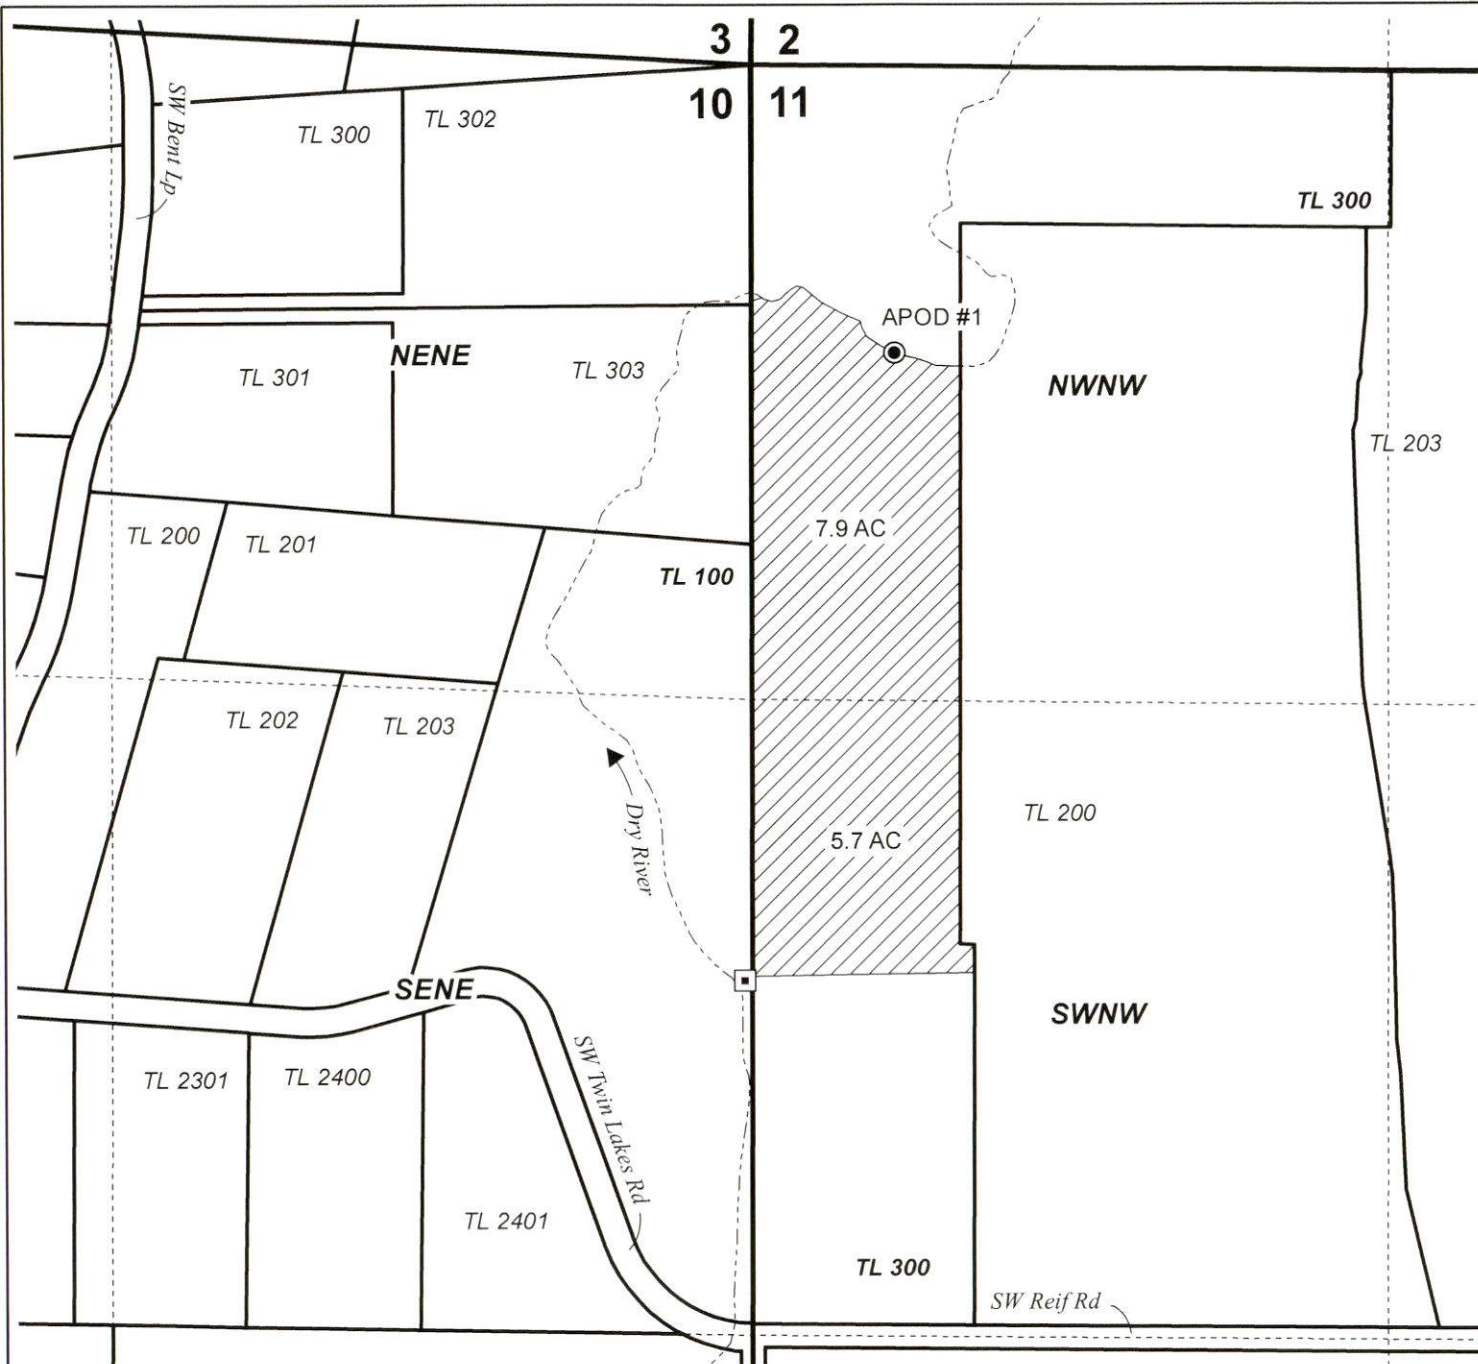

CLAIM OF BENEFICIAL USE MAP
Max Merlich

Date: 11/20/2025

T-13032

This map is not intended
to provide legal dimensions
or locations of property
ownership lines.

WATER RIGHT SERVICES, LLC

PO BOX 1830, BEND, OR 97709

WWW.OREGONWATER.US

brycewrs@gmail.com

541-389-2837

Received
DEC 22 2025
OWRD