

52040

Name Charles A. Haynes
 By _____
 Address Rt.. 2, Box 191, Hillsboro, OR

Application No. 52040
 Permit No. 39219
 Certificate No. 47455
 97123

Stream Index, Page No. 2-62B17

Date filed June 10, 1974
 Priority June 10, 1974
 Action suspended until _____

Return to applicant _____
 Date of approval JAN 28 1976

CONSTRUCTION

Date for beginning JAN 28 1977
 Date for completion OCT 1 1977
 Extended to _____

Date for application of water OCT 1 1978
 Extended to _____

PROSECUTION OF WORK

Form "A" filed March 19, 1976
 Form "B" filed March 19, 1976
 Form "C" filed March 19, 1976

FINAL PROOF

Blank mailed JAN 24 1979
 Proof received _____
 Date certificate issued FEB 9 1979

FEES PAID

Date	Amount	Receipt No.
<u>6-10-74</u>	<u>40.00</u>	<u>40694</u>
_____	_____	_____
_____	_____	_____
<u>1-30-79</u>	<u>2.00</u>	<u>8847</u>

FEES REFUNDED

Date	Amount	Check No.
_____	_____	_____

ASSIGNMENTS

Date	To Whom	Address	Volume	Page
_____	_____	_____	_____	_____
_____	_____	_____	_____	_____
_____	_____	_____	_____	_____

REMARKS

Form C

IMPORTANT—This form is a notice to the State Engineer that permittee is ready to make final proof to the extent to which the water has actually been applied to the intended use under the terms of the permit. Permittee is cautioned that Certificate of Water Right will be issued based on the extent of the quantity and use as determined by the final proof inspection and survey which will be made in response to the filing of this Form C.

NOTE: In the case of an irrigation permit, this Form C should not be mailed to the State Engineer until all of the land described in the permit, which it is intended to irrigate under this permit at any time, has actually been irrigated. Fill out, detach and mail to the State Engineer, Salem, Oregon 97310, when all of the water has been applied.

Application No.

NOTICE OF COMPLETE APPLICATION OF WATER TO A BENEFICIAL USE

I, CHARLES A HAYNES, the holder of Permit No. 39219

to appropriate the public waters of the state of Oregon, completely applied the waters to a beneficial use in accordance with the terms of said permit, on the 17 day of March, 1976

Remarks: all Pipes & supply tank installed and in use

IN WITNESS WHEREOF, I have hereunto set my hand this 17 day of March, 1976

Chas Haynes
(Signature of Applicant)

Route 2 Box 191 Hillsboro
(Address)

Form B

Application No.

NOTICE OF COMPLETION OF CONSTRUCTION

I, Chas Haynes, the holder of Permit No. 39219

to appropriate the public waters of the state of Oregon, completed the construction of the works described therein on the 17 day of March, 1976

Remarks: all completed

If the works have less capacity than described in the permit, or you have definitely abandoned part of the proposed development, you

should so state in order that our records may not be unnecessarily encumbered.

IN WITNESS WHEREOF, I have hereunto set my hand this 17 day of March, 1976

Chas Haynes
(Signature of Applicant)

(Address)

Fill out, detach and mail to the State Engineer, Salem, Oregon 97310, when construction work is completed.

Form A

Application No.

NOTICE OF BEGINNING OF CONSTRUCTION

I, all done, the holder of Permit No. 39219

to appropriate the public waters of the state of Oregon, began the actual construction of the works described therein on the 17 day of March, 1976

Remarks: completed "all in"

The appropriator should state the manner of beginning construction work, number of men employed, the amount of work completed

up to the date of this statement, and any additional information which may tend to show the beginning of work in good faith.


IN WITNESS WHEREOF, I have hereunto set my hand this 17 day of March, 1976

Chas Haynes
(Signature of Applicant)

(Address)

Fill out, detach and mail to the State Engineer, Salem, Oregon 97310, when construction work is begun.

T.2S. R.2W., W.M.

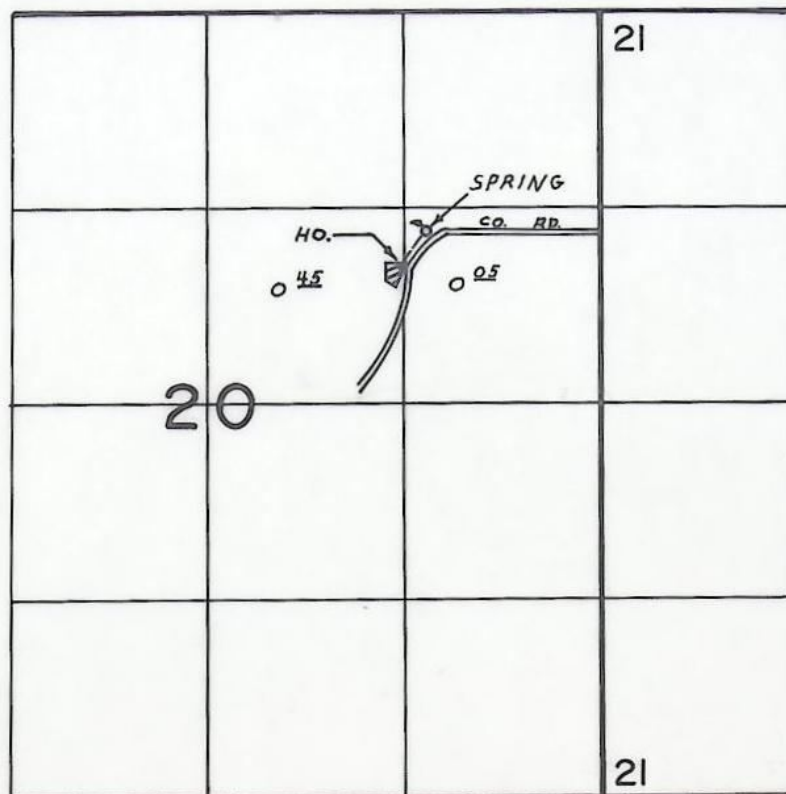

SPRING LOC. 1160' N. & 1170' W. FROM E. 1/4 COR. SEC. 20

FINAL PROOF SURVEY
UNDER

Application No. 52040.. Permit No. 39219.....
IN NAME OF

.....CHARLES A. HAYNES.....

Surveyed SEP..28, 1977, by R.G. MUCKEN....

STATE OF OREGON

COUNTY OF

WASHINGTON

RECEIVED

JAN 30 1979

WATER RESOURCES DEPT.
SALEM, OREGON

Proof of Appropriation of Water

CHARLES A. HAYNES

of Rt. 2, Box 191, Hillsboro
has applied beneficially the waters of
a spring

, State of Oregon, 97123 ,

a tributary of McFee Creek
domestic use for one family and irrigation of 0.5 acre

for the purpose of

under Permit No. 39219 and that the use of said waters has been completed under the
terms of said permit; that the priority of the right dates from
June 10, 1974

that the amount of water for the purposes aforesaid, has been actually beneficially used in the
amount of

0.01 cubic foot per second, being 0.005 c.f.s. for domestic and 0.005 c.f.s.
for irrigation

or its equivalent in case of rotation, measured at the point of diversion from the stream.
The point of diversion is located in the SE $\frac{1}{4}$ NE $\frac{1}{4}$, Section 20, T. 2 S., R. 2 W., W. M.,
1160 feet North and 1170 feet West from the E $\frac{1}{2}$ Corner, Section 20

The amount of water used for irrigation, together with the amount secured under any other
right existing for the same lands, shall be limited to one-eightieth of one cubic foot per second
per acre, or its equivalent for each acre irrigated and shall be further limited
to a diversion of not to exceed 2 $\frac{1}{2}$ acre feet per acre for each acre irrigated
during the irrigation season of each year,

and shall
conform to such reasonable rotation system as may be ordered by the proper state officer.

A description of the place of use under the right, and to which such right is appurtenant, is
as follows:

Domestic & 0.45 acre SW $\frac{1}{4}$ NE $\frac{1}{4}$
0.05 acre SE $\frac{1}{4}$ NE $\frac{1}{4}$
Section 20
T. 2 S., R. 2 W., W. M.

I have read the above and foregoing proof of appropriation of water; I know the contents
thereof, and that the facts therein stated are true.


IN WITNESS WHEREOF, I have hereunto set my hand this 29 day of Jan.,

1979

Charles A. Haynes

RECEIVED
JUN 10 1974
STATE ENGINEER
SALEM, OREGON

T. 2 S. R. 2 W. W. M.

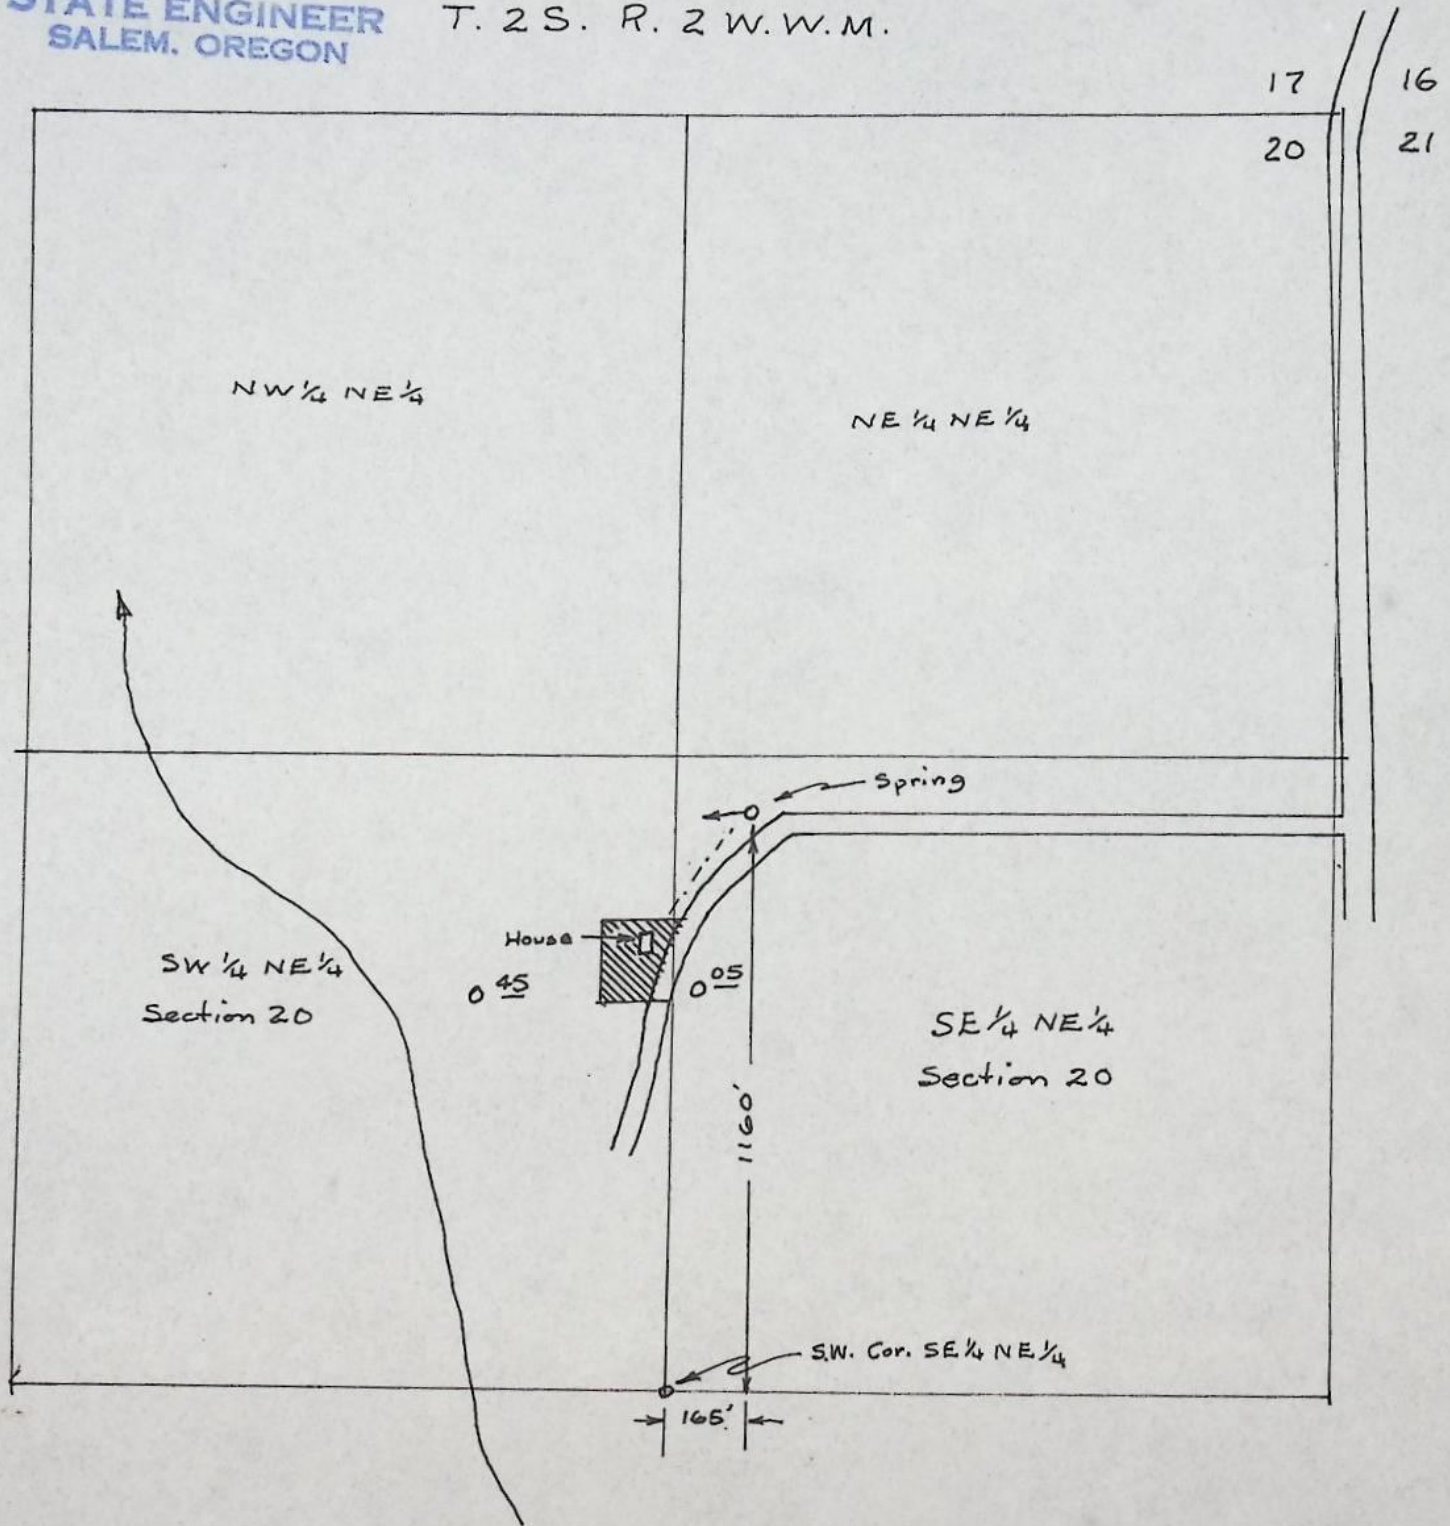

SCALE 1 in. = 400 ft.

Application No. 52040
Permit No. 39219

7:15 A.M. @ SCHOLLS GAR AGE

628-1288

Abstract of Permit No. 39219 ✓

Box

Application No. 52040 ✓

Certificate No.

Name Charles A. Haynes ✓
Address Route 2, Box 191
Hillsboro, OR 97123

Source of water supply A spring, TRIB, McFEE CREEK, TURNER R.

Use Domestic use for one family and irrigation of 0.5 AC. ✓

Point of diversion 1160' N & 165' E from SW c., SE 1/4 NE 1/4 s. 20, being within SE 1/4 NE 1/4 s. 20, T. 2 S., R. 2 W., W.M.; Washington County ✓

Number of acres 0.5

DESCRIPTION OF LAND TO BE IRRIGATED OR PLACE OF USE

Twp.	Range	Sec.	NE 1/4				NW 1/4				SW 1/4				SE 1/4			
			NE 1/4	NW 1/4	SW 1/4	SE 1/4	NE 1/4	NW 1/4	SW 1/4	SE 1/4	NE 1/4	NW 1/4	SW 1/4	SE 1/4	NE 1/4	NW 1/4	SW 1/4	SE 1/4
2 S	2 W	20	✓		0.45													
					DOM 0.05													
					SW 1/4 NE 1/4												DOM 0.45	✓
					SE 1/4 NE 1/4												0.05	✓

Priority date June 10, 1974 ✓

Amount of water 0.01 c.f.s., being 0.005 c.f.s. for domestic and 0.005 c.f.s. for irrigation ✓

Time limit to begin construction 1-28-77

Time limit to complete construction 10-1-78 extended to extended to

Time limit to completely apply water 10-1-79 extended to extended to

Remarks: Limitations: 1/80th c.f.s., 2 1/2 a.f.

DBS-444-99
 9-28-77
 R.G.M.
 CG,
 McFee Cr. MISC.
 NOT HOME
 9-9-76
 R.G.M.
 Basin 2, Volume 22

INFO: Mr. Haynes

Water is used as filed

DIV - SPRING IS BURIED & LOC. IN A FILBERT ORCHARD
IT IS ENCLOSED IN A BRICK STRUCTURE - NOT VISIBLE

PIPE - $1\frac{1}{4}$ " P.V.C. TO A 500 GAL BURIED TANK BY HO.
GARDEN HOSE & 1 YARD SPRINKLER FOR IRR.

PUMP & MOTOR - A $\frac{1}{2}$ H.P. ELECTRIC RATED @ 1250 GP/HOUR

USE - DOMESTIC USE 1 FAMILY & IRRIGATION of YARD

LIFT - - 20' TO HOUSE FROM SPRING


TIE - DBS-4LL-99

9-28-77

R.G. Muehlen

RECEIVED
JUN 10 1974
STATE ENGINEER
SALEM, OREGON

T. 2 S. R. 2 W. W. M.

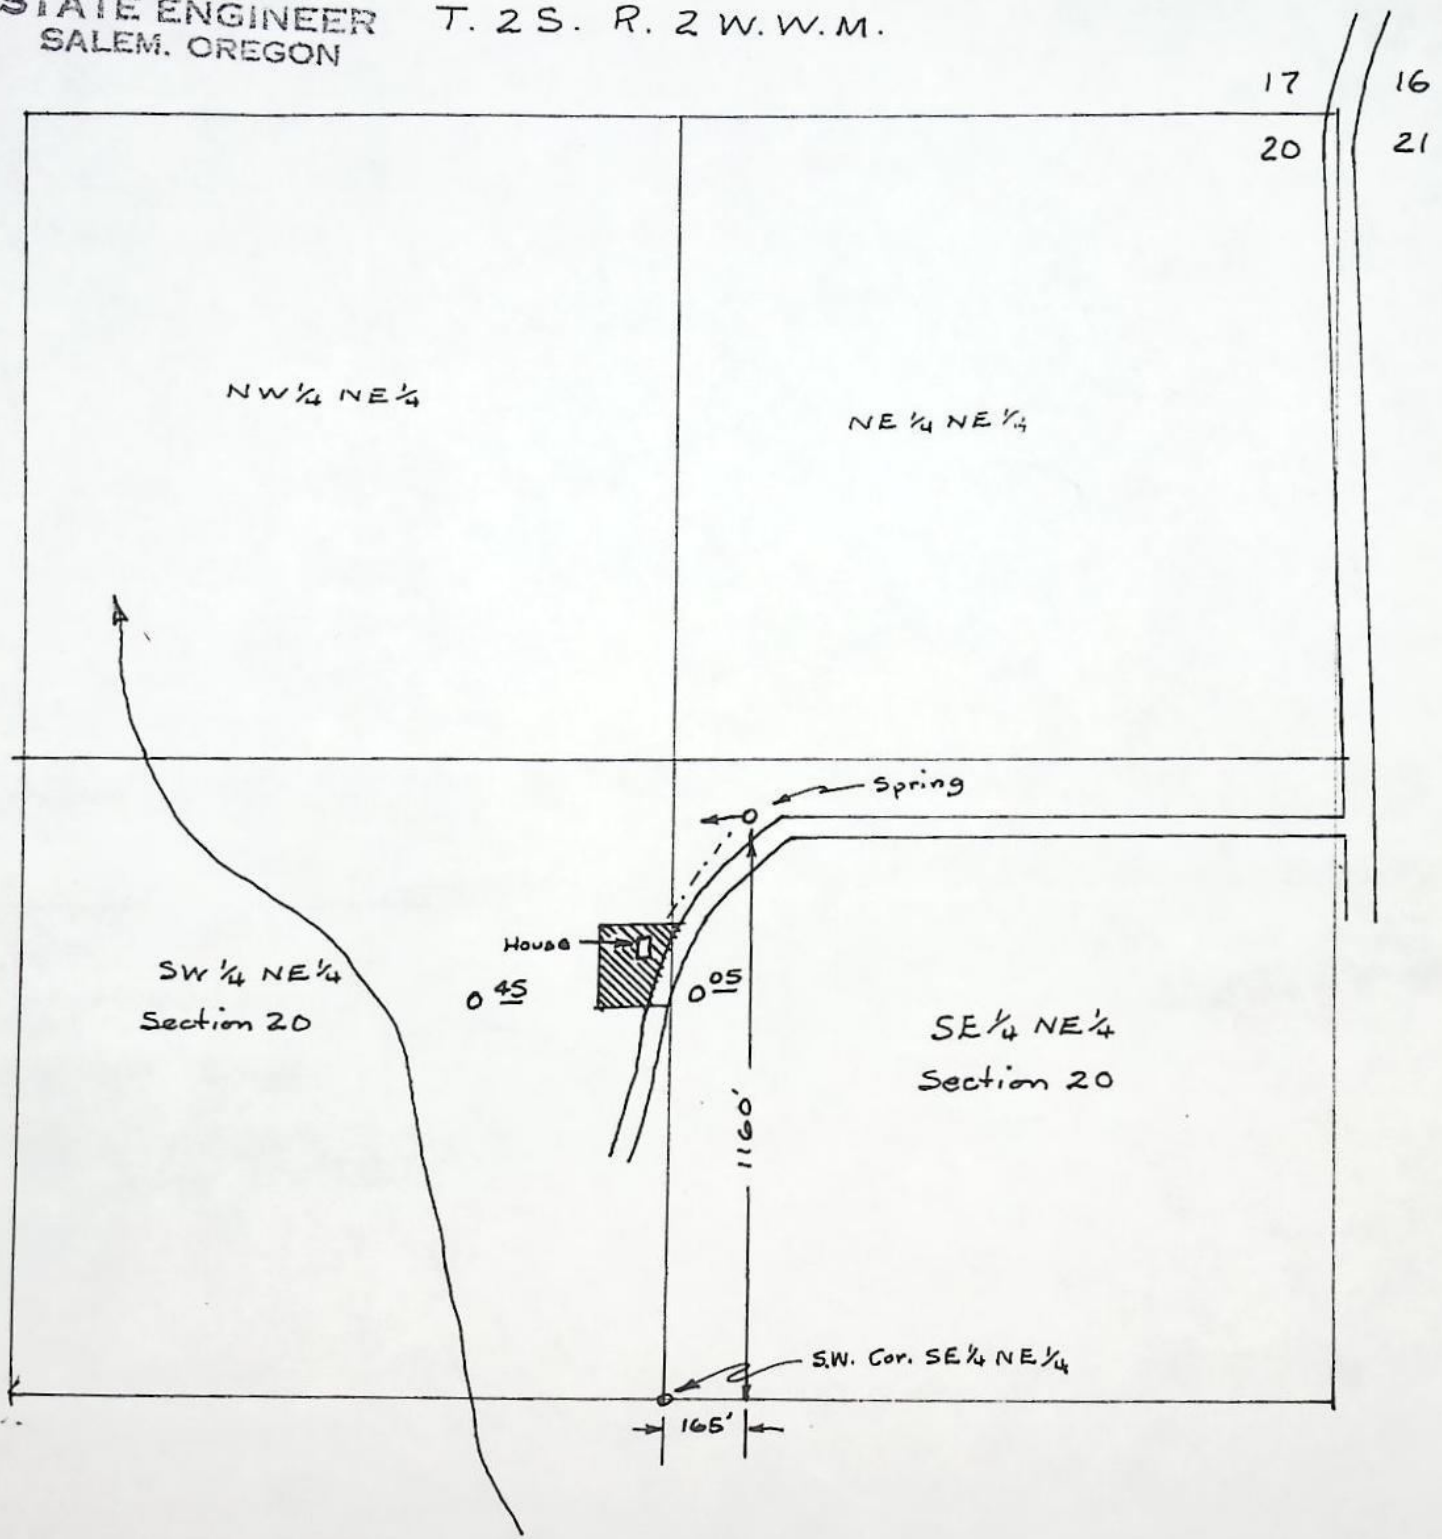

SCALE 1 in. = 400 ft.

Application No. 52040
Permit No. 39219

Scholls Automotive Parts & Machine

DON HAYNES

Auto and Tractor Repair and Rebuild—General Repairing—Electric & Acetylene Welding

Route No. 2, Hillsboro, Oregon 97123

XXXXXXXXXX-XXXXXX

PHONE 628-1288

Name Owner _____ Date _____

Address _____ Phone _____

Make Car _____ Model _____ Year _____ License _____

Motor No. _____ Serial No. _____ Mileage _____

[illegible]

Beginning at the SE ~~4~~ corner of the SW $\frac{1}{4}$ NE $\frac{1}{4}$
Section 20 T 2 S R 2 W. W. M. thence
North 9.6 chains to the point of beginning
thence N 2.5 chains, thence west 2 chains,
thence south 2.5 chains, thence east
2 chains to the P.O.B.

RECEIVED
JUN 10 1974
STATE ENGINEER
SALEM, OREGON

RECEIVED
JUN 10 1974
STATE ENGINEER
SALEM, OREGON

Application No. _____

DESCRIPTION OF SPRING

1. Is spring on property of applicant? no
2. If not, give name and address of legal owner. Shaner Walnut Co
R1- Newberg Oregon
3. Have you secured consent of owner to appropriate water from this spring and for construction of pipeline or other works? yes
4. If you do not have such consent, do you expect to secure right of way through condemnation? yes
5. What is the maximum flow from spring? 4 1/2 gal Per min
(Gallons per minute or
cubic feet per second)
- What is the minimum flow? 1 gal Per min
- Is flow measured or estimated? measured
6. Does the stream flowing from spring form a well defined natural channel? spring
7. Does the water flow off the lands on which it first arises? no
8. Give the name of the stream or other body of water into which water from the spring flows. _____
9. If the water from the spring sinks or evaporates before reaching other water, give distance water flows from spring before vanishing.

10. Remarks Spring has been in use since in
LATE 1800

Charles Haynes
Signature of Applicant

Application No. 52040
Permit No.

February 9, 1976

Charles A. Haynes
Rt. 2, Box 191
Hillsboro, OR 97123

52040

39219 with map.

July 30, 1974

52040

Charles A. Haynes
Route 2, Box 191
Hillsboro, OR 97123

Dear Mr. Haynes:

This will acknowledge your application for a permit to appropriate 0.01 cubic foot of water per second from McFee Creek, being 0.005 cubic foot of water per second for domestic use for one family and 0.005 cubic foot of water per second for irrigation of garden and lawn not to exceed 1/2 acre in area, along with a map prepared on tracing paper, legal description, spring description sheet, and fees of \$40.00. Our receipt No. 40694 was handed to you.

The application is in satisfactory form for approval by the issuance of a permit.

Very truly yours,

WAYNE J. OVERCASH
Assistant

WO:jg