



13858 WATER RIGHT
 Don
 Still On File
 June 30
 2007

T.4S. R.1W.
Sec. 26, 27, 34, & 35 W.M.

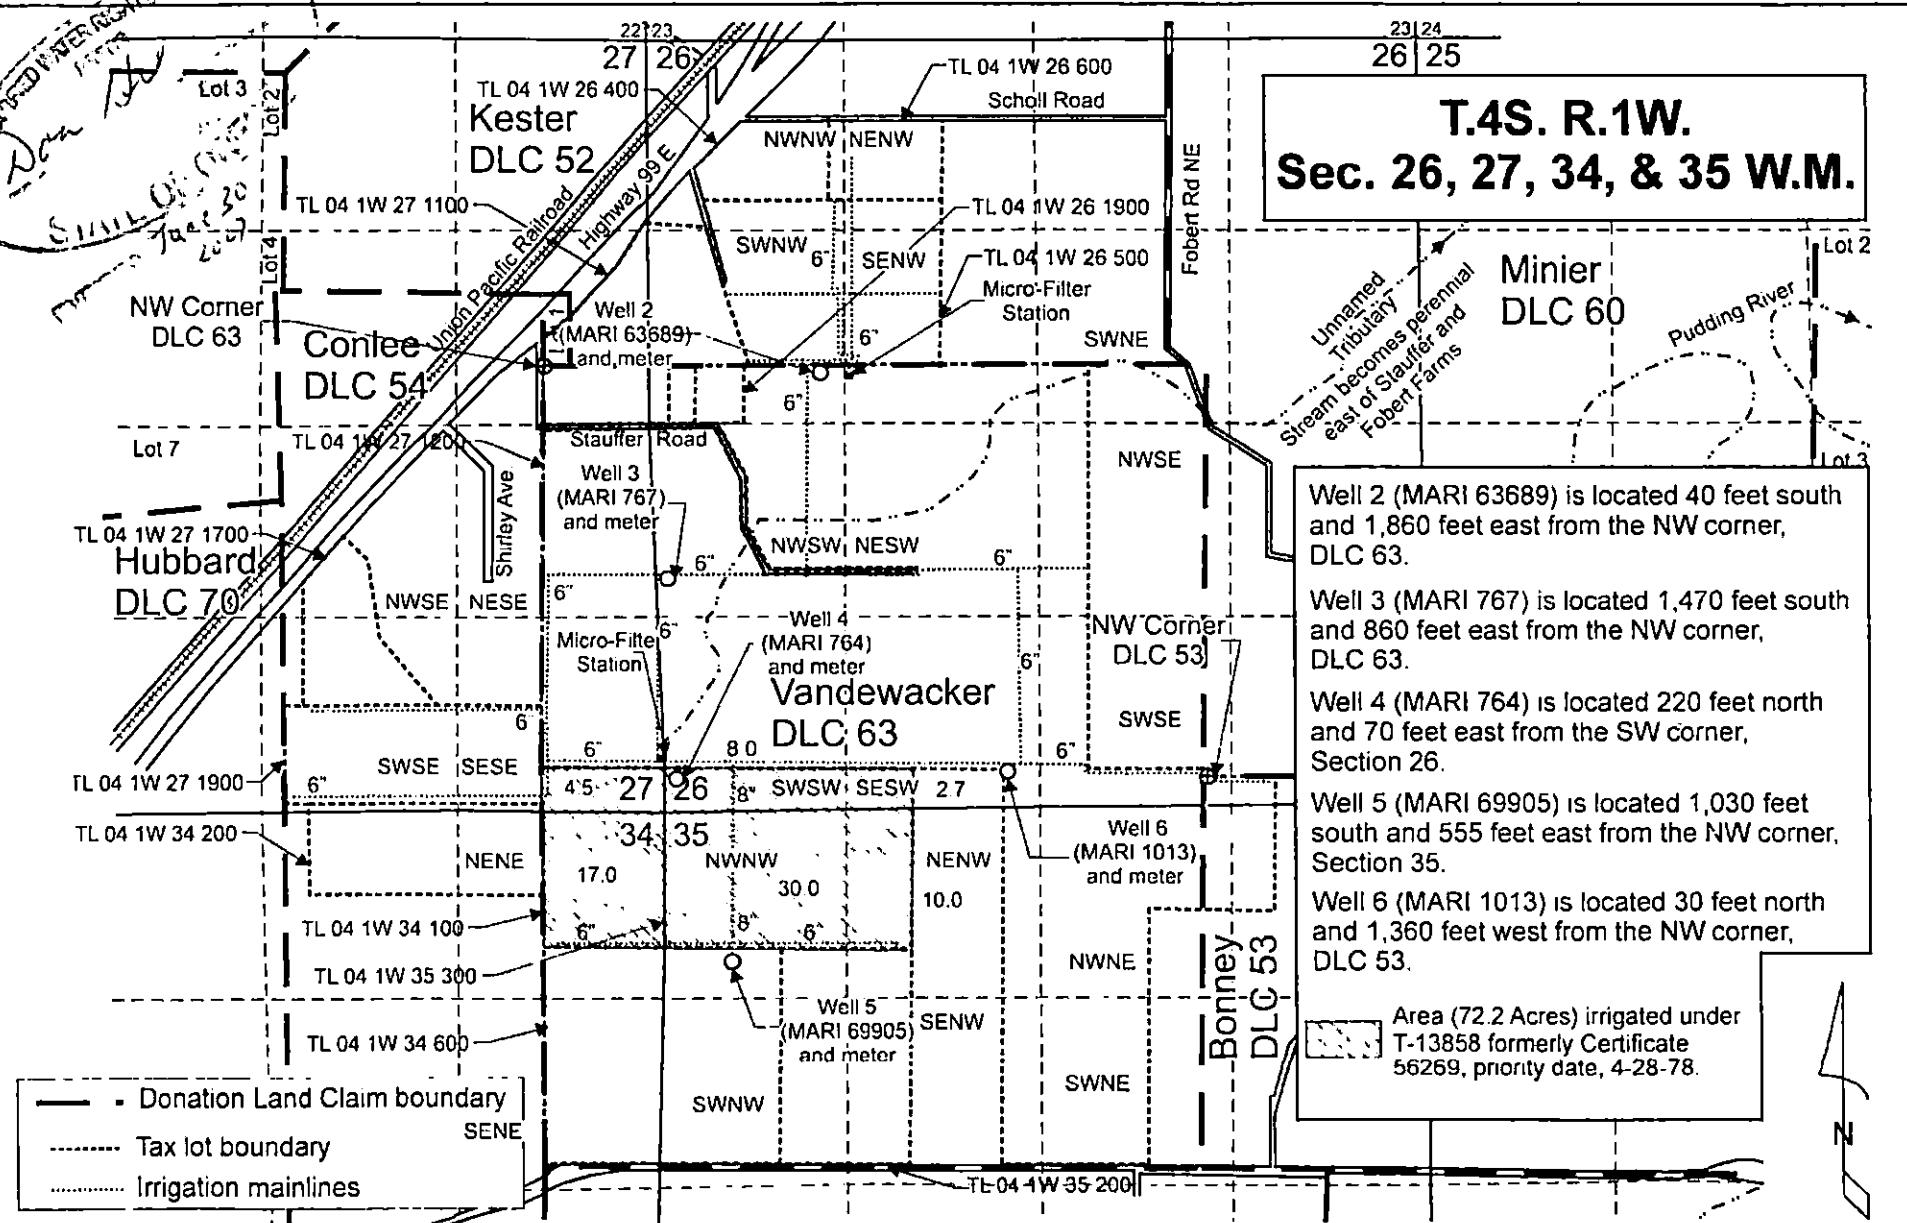

Well 2 (MARI 63689) is located 40 feet south and 1,860 feet east from the NW corner, DLC 63.
 Well 3 (MARI 767) is located 1,470 feet south and 860 feet east from the NW corner, DLC 63.
 Well 4 (MARI 764) is located 220 feet north and 70 feet east from the SW corner, Section 26.
 Well 5 (MARI 69905) is located 1,030 feet south and 555 feet east from the NW corner, Section 35.
 Well 6 (MARI 1013) is located 30 feet north and 1,360 feet west from the NW corner, DLC 53.
 Area (72.2 Acres) irrigated under T-13858 formerly Certificate 56269, priority date, 4-28-78.

- - - - - Donation Land Claim boundary
- Tax lot boundary
- Irrigation mainlines

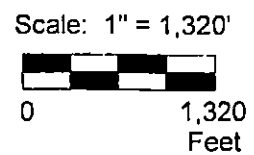

This map was prepared for the purpose of identifying the location of a water right only and is not intended to provide legal dimensions or location of property ownership lines.



Claim of Beneficial Use Map
T-13858 formerly, Certificate 56269
 Stauffer Farms Inc.
 T.4S. R.1W. Sec. 26, 27, 34 & 35, W.M.
 12/2025

StaufferTransMap odr

15533
 Don't
 STATE OF OREGON
 7-10-20
 6-27


T.4S. R.1W.
Sec. 26, 27, 34, & 35 W.M.

Minier
 DLC 60
 Unnamed Tributary
 comes perennial
 water and
 forms
 Pudding River

Well 2 (MARI 63689) is located 40 feet south and 1,860 feet east from the NW corner, DLC 63.
 Well 3 (MARI 767) is located 1,470 feet south and 860 feet east from the NW corner, DLC 63.
 Well 4 (MARI 764) is located 220 feet north and 70 feet east from the SW corner, Section 26.
 Well 5 (MARI 69905) is located 1,030 feet south and 555 feet east from the NW corner, Section 35.
 Well 6 (MARI 1013) is located 30 feet north and 1,360 feet west from the NW corner, DLC 53.

Area (54.8 Acres) primary irrigation under T-13858 formerly Certificate 89385, priority date, 4-28-78.
 Area (29.7 Acres) supplemental irrigation under T-13858 Certificate 89385, priority date, 4-28-78. Primary is GR-785.

— Donation Land Claim boundary
 - - - Tax lot boundary
 Irrigation mainlines

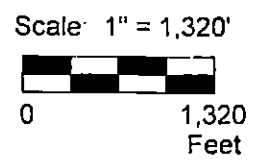


This map was prepared for the purpose of identifying the location of a water right only and is not intended to provide legal dimensions or location of property ownership lines.

WILL MCGILL SURVEYING LLC

Claim of Beneficial Use Map
T-13858 formerly, Certificate 89385
 Stauffer Farms Inc.
 T.4S. R.1W. Sec. 26, 27, 34 & 35, W.M.

StaufferTransMap.cdr

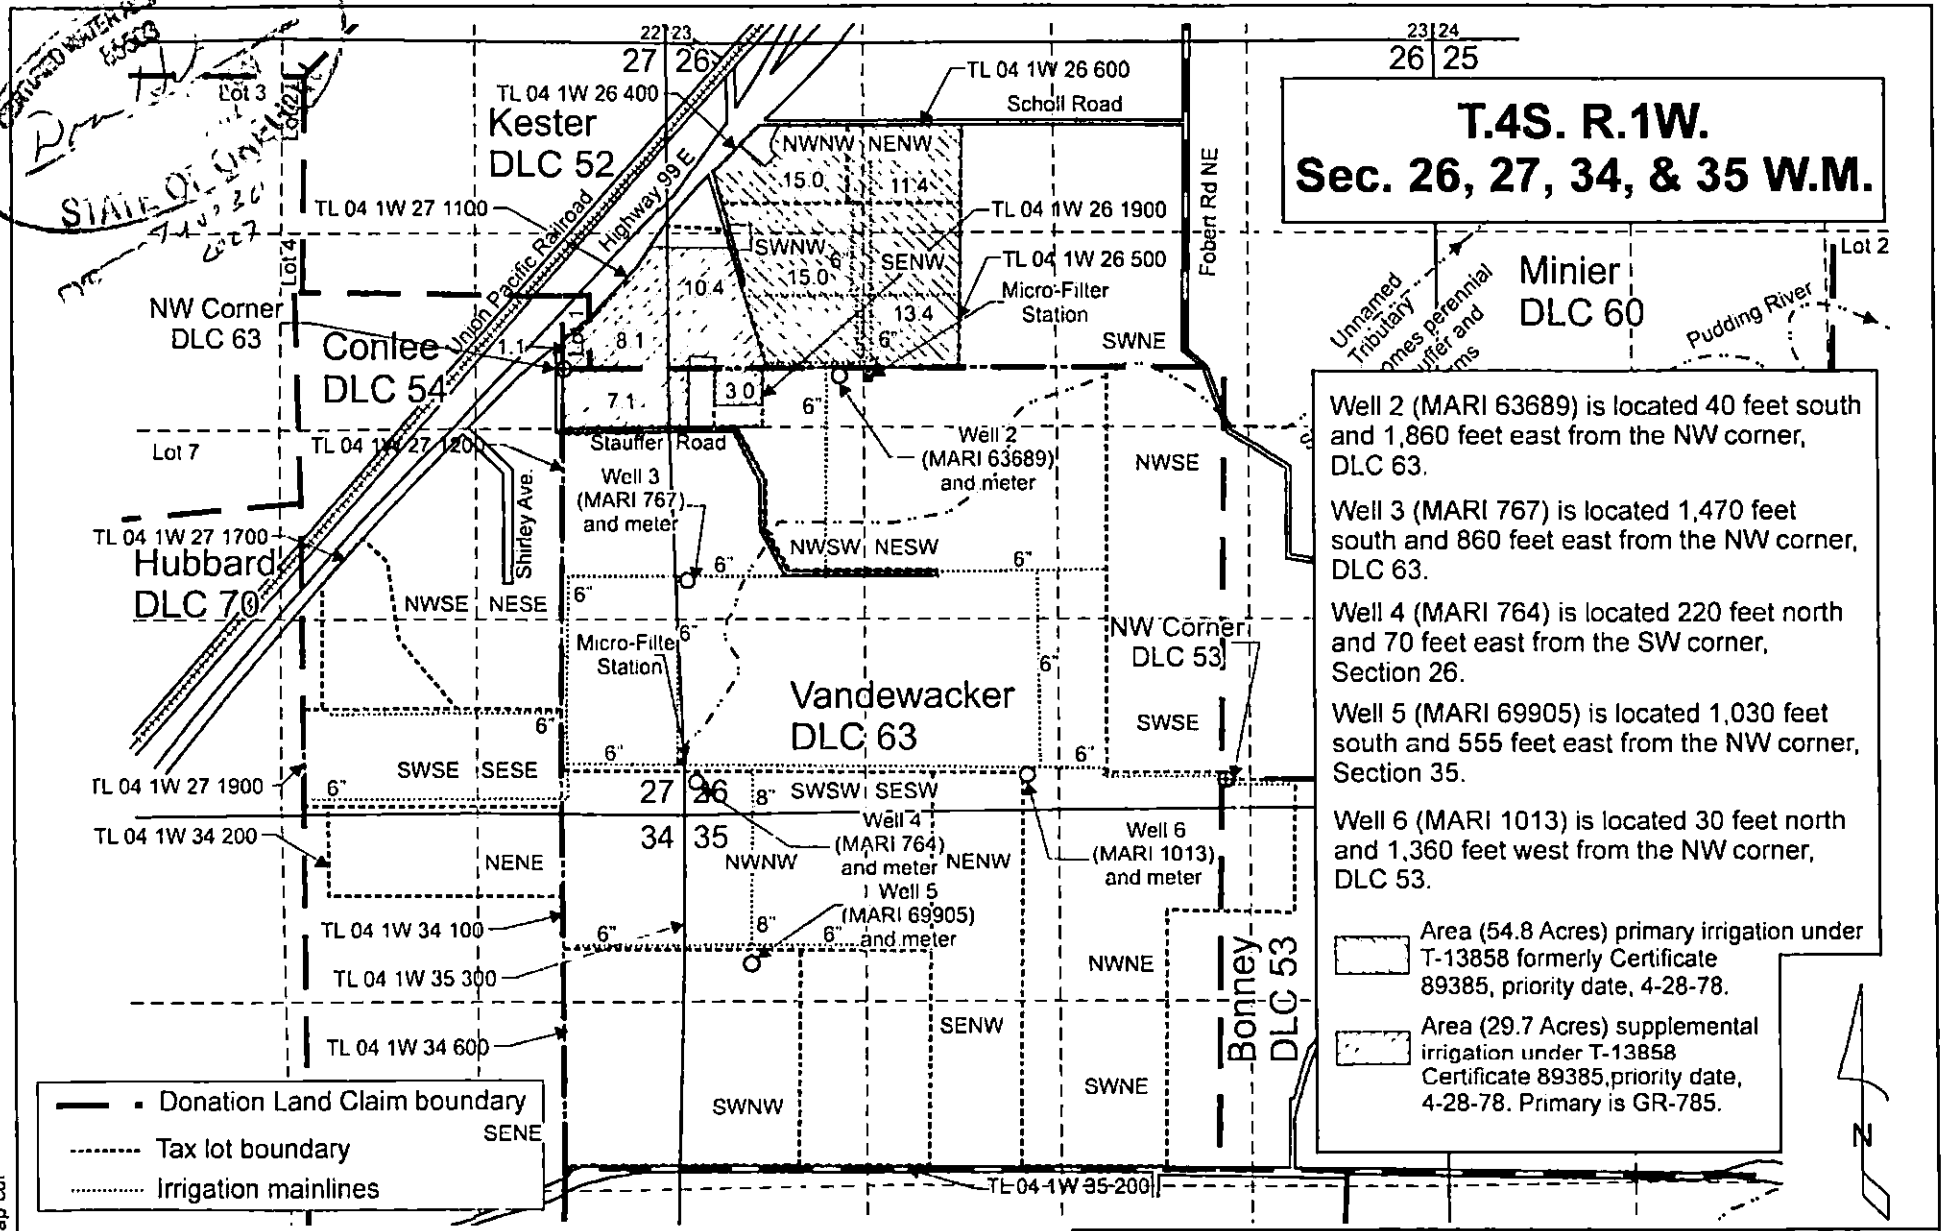

**T.4S. R.1W.
Sec. 26, 27, 34, & 35 W.M.**

Well 2 (MARI 63689) is located 40 feet south and 1,860 feet east from the NW corner, DLC 63.

Well 3 (MARI 767) is located 1,470 feet south and 860 feet east from the NW corner, DLC 63.

Well 4 (MARI 764) is located 220 feet north and 70 feet east from the SW corner, Section 26.

Well 5 (MARI 69905) is located 1,030 feet south and 555 feet east from the NW corner, Section 35.

Well 6 (MARI 1013) is located 30 feet north and 1,360 feet west from the NW corner, DLC 53.

Area (78.5 Acres) irrigated under T-13858 formerly Certificate 46907, priority date, 1-7-74

Legend:

- Donation Land Claim boundary
- - - Tax lot boundary
- Irrigation mainlines

T.4S. R.1W.
Sec. 26, 27, 34, & 35 W.M.

Minier
DLC 60

Well 2 (MARI 63689) is located 40 feet south and 1,860 feet east from the NW corner, DLC 63.

Well 3 (MARI 767) is located 1,470 feet south and 860 feet east from the NW corner, DLC 63.

Weil 4 (MARI 764) is located 220 feet north and 70 feet east from the SW corner, Section 26.


Well 5 (MARI 69905) is located 1,030 feet south and 555 feet east from the NW corner, Section 35

Well 6 (MARI 1013) is located 30 feet north and 1,360 feet west from the NW corner, DLC 53.

Area (78.5 Acres) irrigated under
T-13858 formerly Certificate
46907, priority date, 1-7-74.

CERTIFIED WATER RIGHT MAP
 28503
 Don
 SIA
 11-24-59
 26-27

T.4S. R.1W. **Sec. 26, 27, 34, & 35 W.M.**

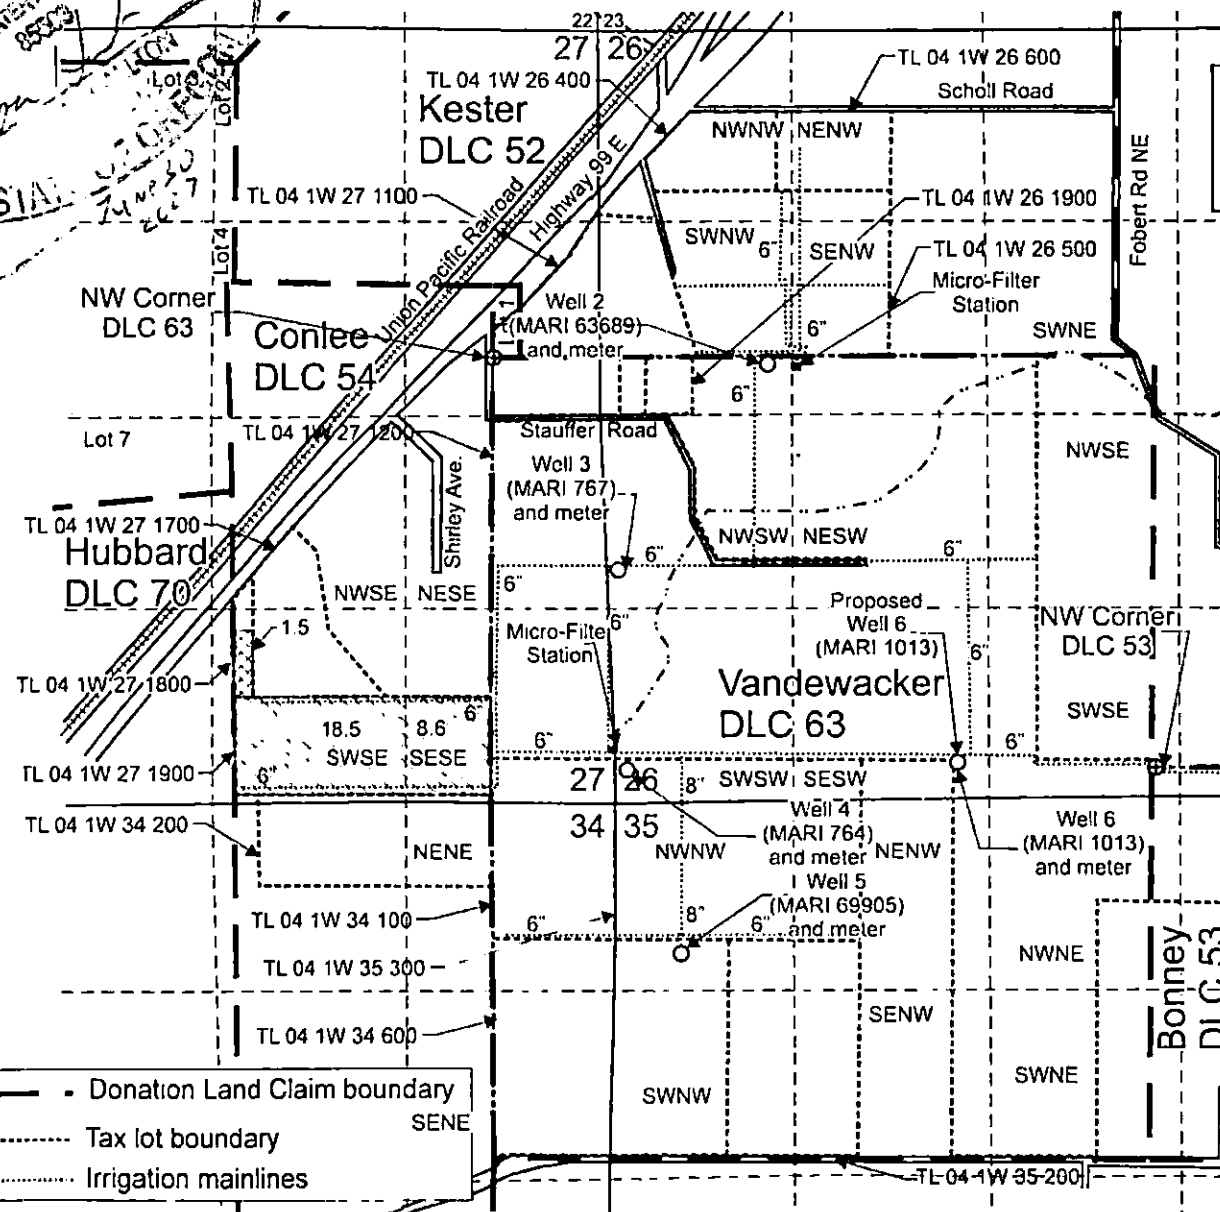

Well 2 (MARI 63689) is located 40 feet south and 1,860 feet east from the NW corner, DLC 63.
 Well 3 (MARI 767) is located 1,470 feet south and 860 feet east from the NW corner, DLC 63.
 Well 4 (MARI 764) is located 220 feet north and 70 feet east from the SW corner, Section 26.
 Well 5 (MARI 69905) is located 1,030 feet south and 555 feet east from the NW corner, Section 35.
 Well 6 (MARI 1013) is located 30 feet north and 1,360 feet west from the NW corner, DLC 53.

Area (27.1 Acres) irrigated under T-13858 formerly Certificate 29406, priority date, 11-24-59,

Area (1.5 Acres) irrigated under T-13858 formerly, Certificate 29406, priority date, 11-24-59



Scale: 1" = 1,320'



0 1,320 Feet

This map was prepared for the purpose of identifying the location of a water right only and is not intended to provide legal dimensions or location of property ownership lines.

WILL MCGILL SURVEYING LLC

12/2025

Claim of Beneficial Use Map
 T-13858 formerly, Certificate 29406

Stauffer Farms Inc.
 T.4S. R.1W. Sec. 26, 27, 34 & 35, W.M.