


LEGEND

- IR
- IS
- Sump Well
- Pivot Pad
- Baker County Taxlot Boundary 0400

Mainlines

- 12"
- 8"
- 6"

Received
 JAN 05 2026
 OWRD

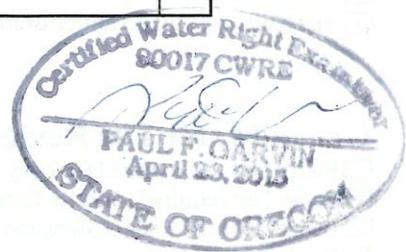

App:G-14009



**Map to Accompany Claim
 of Beneficial Use Permit G-12625
 Baker County, OR**

Prepared on behalf of Rohner Farms

1 inch = 1,320 ft



Date: 6/14/2025
 Drawn by: Paul F. Garvin

Notes:

This map is not intended to provide legal dimensions or locations of property ownership lines.

Well: 2,780' N and 1,390' W from the SE corner of Section 2

Flowmeter located within a 15 ft radius of the point of appropriation

Primary irrigation per QQ denoted in bold font

Supplemental Irrigation per QQ denoted in regular font