




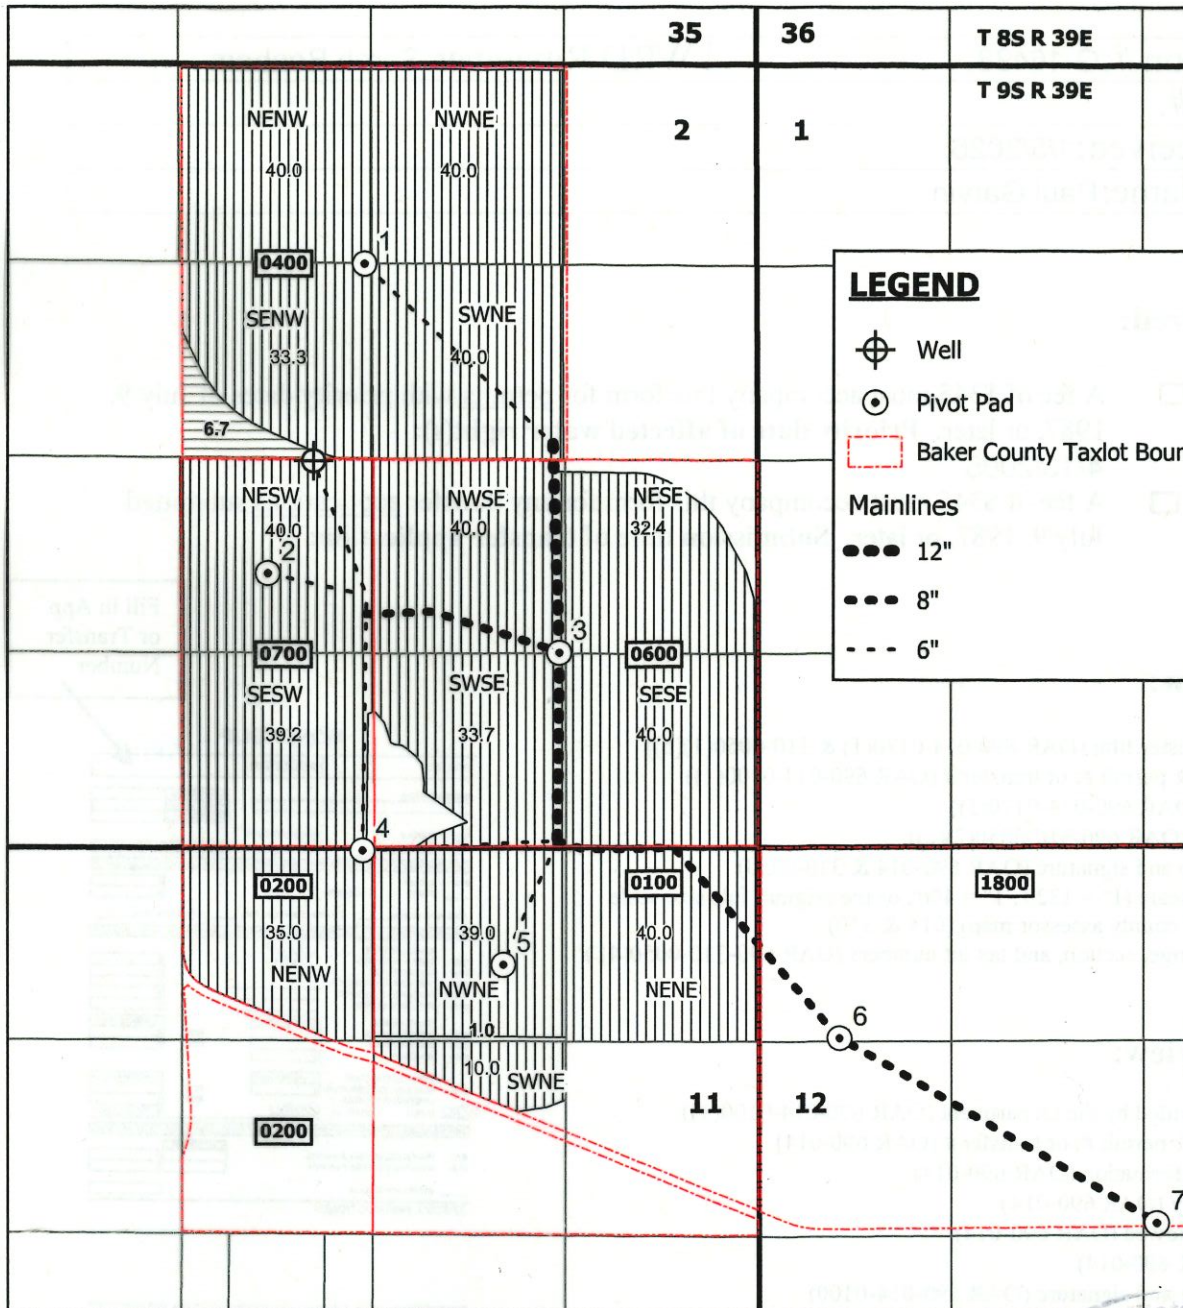

Received
JAN 05 2026
OWRD

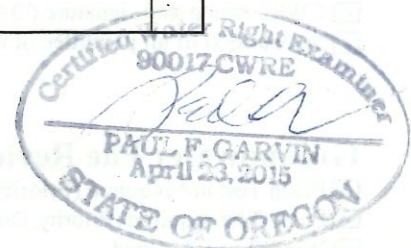

App #G-14638

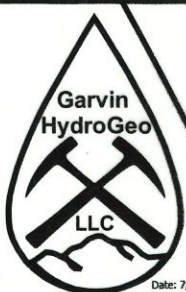

Map to Accompany Claim of Beneficial Use Permit G-16009 Baker County, OR

Prepared on behalf of Rohner Farms

1 inch = 1,320 ft



Notes:

This map is not intended to provide legal dimensions or locations of property ownership lines.

Well: 2,600' N and 3,045' W from the SE Corner of Section 2

Flowmeter located within a 15 ft radius of the point of appropriation

Primary irrigation per QQ denoted in bold font

Supplemental Irrigation per QQ denoted in regular font

Date: 7/14/2025
Drawn by: Paul F. Garvin