


Township 38S., Range 4W.

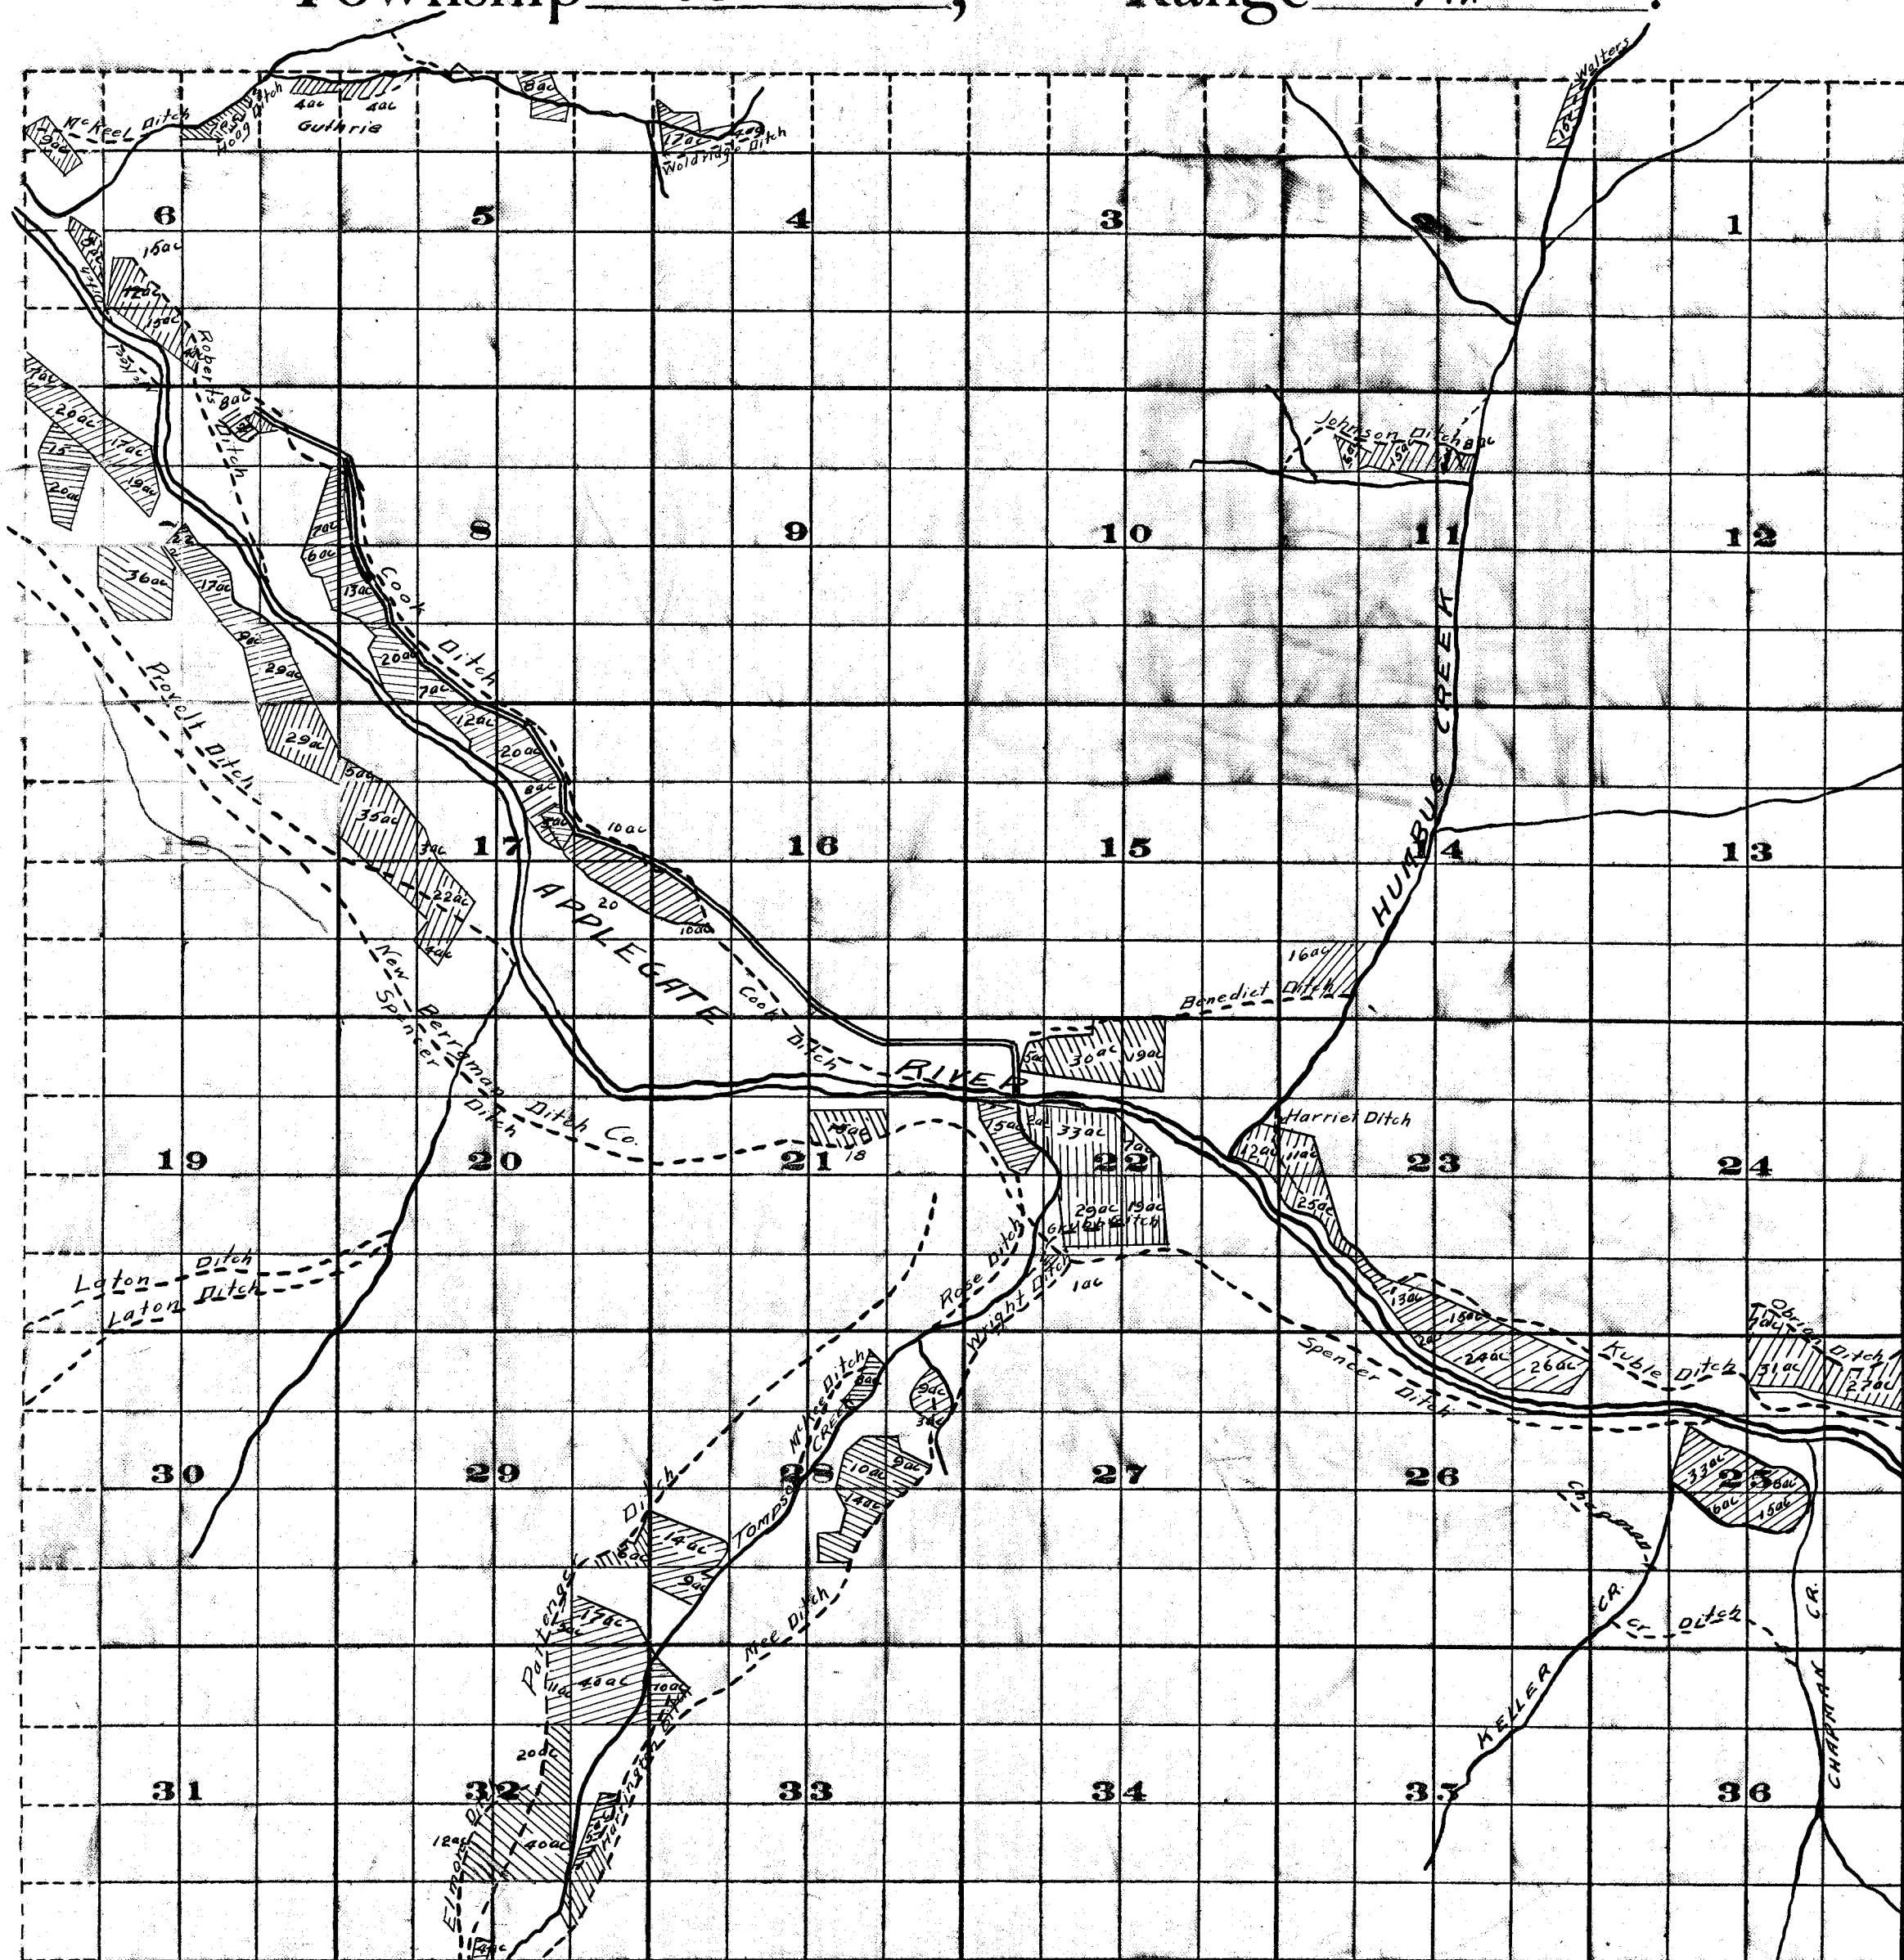

Survey by McMahon April 1910

M.D.
D.F.M. 11/2/11

Scale of Feet.

FROM OFFICE OF THE STATE ENGINEER, SALEM, OREGON

Adjudication
Rogue River and Tributaries
John H. Lewis State Engr.

Examined Sept. 18, 1911