

10 2W 07B

10 2W 07B



SEE MAP 103W01 1 6

SEE MAP 102W06

400  
12  
7

NE COR  
R. WOODRIF  
D.C. #

399

NW COR  
J. TERHUNE  
D.C. 56

ELIZABETH WY SE

NW COR  
L. TERHUNE  
D.C. 57

SW COR  
E.H. BERLINGER  
D.C. 57

14 53 0

500

2003-041  
200  
PARCEL 1  
2.39AC

P.P.

210  
PARCEL 1  
2.82AC

100  
PARCEL 2  
2.25AC

P.P.

700  
PARCEL 1  
6.00AC

1991-083


EMERALD GREEN LANE

Received by OWRD  
JAN 08 2026  
Salem, OR

\* Existing well located 1,620' south and 87' west from northwest corner of the Taber Terhune Land Claim no. 56.  
4.5 acres to be irrigated.  
Tax Lot 102W07C 0200  
Main conveyance pipe.



Tax Lot 102W07C 0200

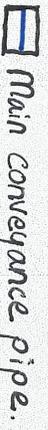

Main conveyance pipe.

SEE MAP 102W07

NE SW

SE NW

SEE MAP 102W07C

3.5 acre

1 acre

EMERALD GREEN LANE

SEE MAP 102W07D

CTR SEC

MARION COUNTY, OREGON  
NW1/4 SECT 1105 R2W W.M.  
SCALE 1" = 200'



LEGEND

- LINE TYPES
  - Taxlot Boundary
  - Road Right-of-Way
  - Railroad Right-of-Way
  - Private Road ROW
  - Subdivision/Plat Boundary
  - Waterline - Taxlot Bndry
  - Waterline - Non Bndry
  - Historical Boundary
  - Easement
  - Railroad Centerline
  - Taxcode Line
  - Map Boundary
  - Waterline - Non Bndry

CORNER TYPES

- + 1/16TH Section Cor
- ⊕ 1/4 Section Cor
- ⊙ D.C. Corner
- ⊕ 16'15" Section Corner
- ⊕ 21'22" Section Corner

NUMBERS  
Tax Code Number  
00 00 0

Acreage  
All acres listed are Net Acres, excluding any portions of the taxlot within public ROWs

NOTES

Tick Marks: A tick mark in the road indicates that the labeled dimension extends into the public ROW



CANCELLED NUMBERS


DISCLAIMER: THIS MAP WAS PREPARED FOR ASSESSMENT PURPOSES ONLY



FOR ADDITIONAL MAPS VISIT OUR WEBSITE AT [www.co.marion.or.us](http://www.co.marion.or.us)

PLOT DATE: 10/17/2020

10 2W 07B

10 2W 07B