

LOCATED IN
SECTION 34 & 35; T1N R13E W.M.
WASCO COUNTY, OREGON
CLAIM OF BENEFICIAL USE MAP

TAX LOT 2600 APPLICATION G-16318
TAX MAP 01N 13E PERMIT G-15858

CWRE STATEMENT
THIS MAP IS NOT INTENDED TO PROVIDE LEGAL DIMENSIONS OF
LOCATIONS OF PROPERTY OWNERSHIP LINES.

MAP INFORMATION
COORDINATE SYSTEM: STATE PLANE OREGON NORTH ZONE 3601
DATUM: NORTH AMERICAN DATUM OF 1983


DATA SOURCES
TAX LOT AND ROAD: WASCO COUNTY GIS
SECTION LINEWORK: WASCO COUNTY GIS

PREPARED FOR
CATHRYN POLEHN OXFORD
3452 FIVE MILE ROAD
THE DALLES, OR 97058




LEGEND

TAX LOT BOUNDARY	—————	PRIMARY WATER RIGHTS FROM WELL	
1/4 1/4 SECTION LINE	- - - - -	SUPPLEMENTAL WATER RIGHT (CERTIFICATE 31717)	
SECTION LINE	—————	SUPPLEMENTAL WATER RIGHT (CERTIFICATE 6758)	
WELL CONVEYANCE SYSTEM	—————		
STREAM/RIVER	- - - - -		
POINT OF APPROPRIATION (POA) WELL: 1005' NORTH AND 660' EAST FROM SW CORNER, SECTION 35			

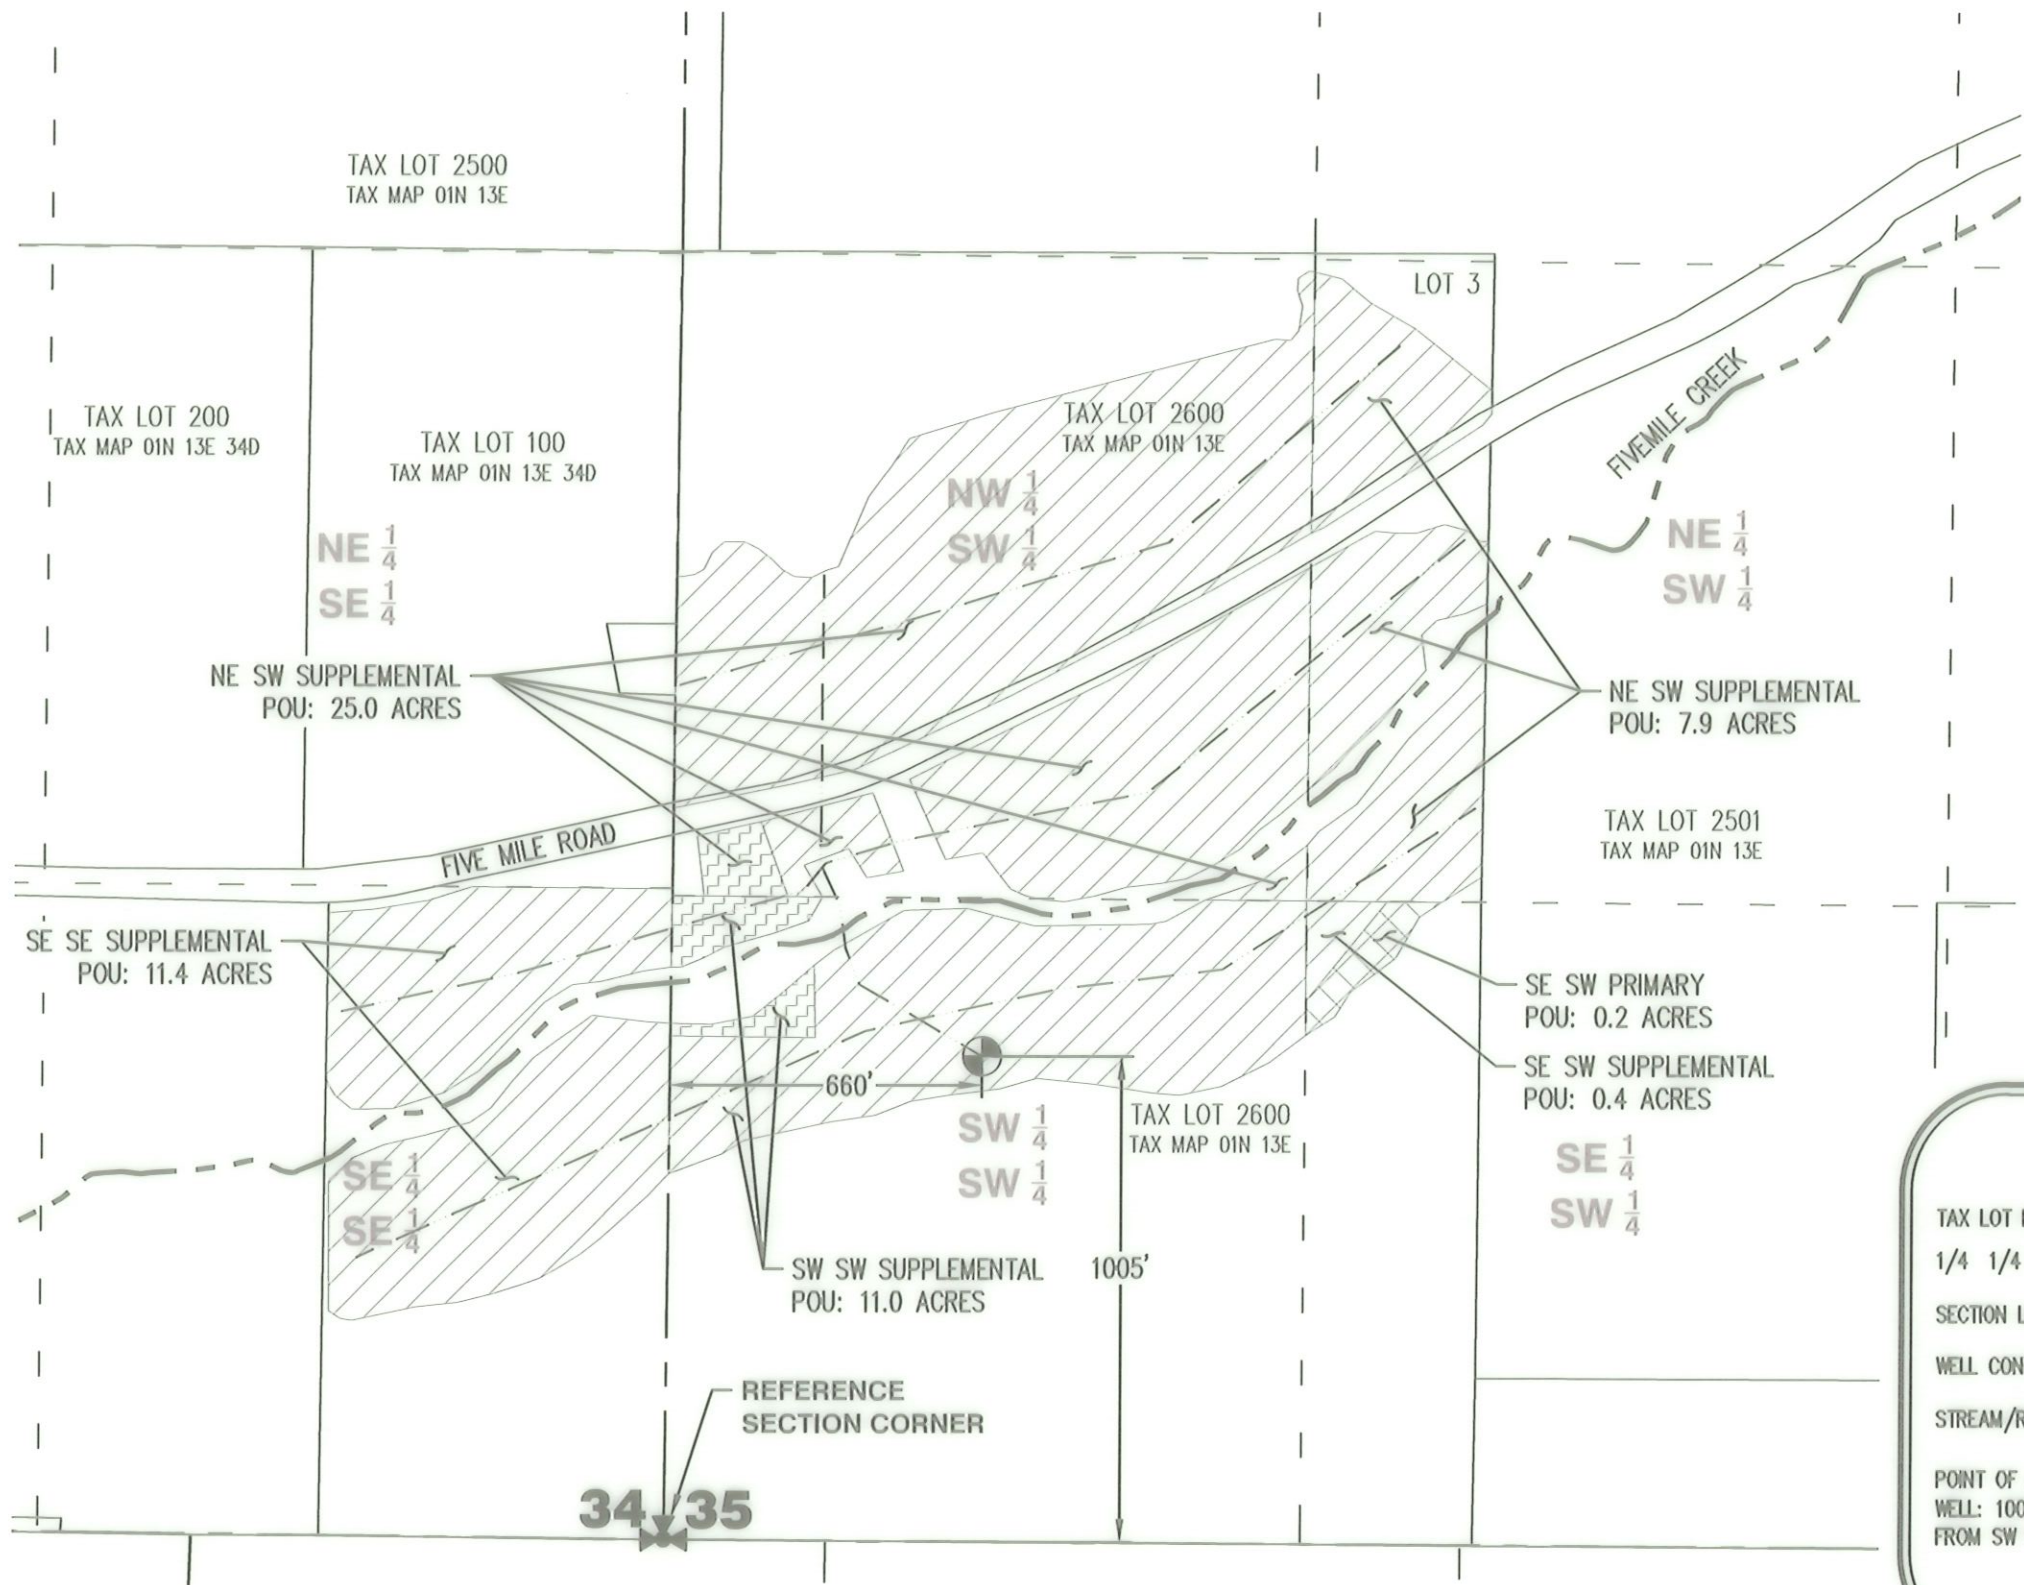

Received
JAN 08 2026
OWRD

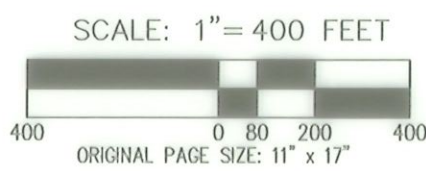

CLAIM OF BENEFICIAL USE MAP		DATE: 12/11/2025
3450 Five Mile Road Water Rights		EXHIBIT
AKS ENGINEERING & FORESTRY, LLC		A
12965 SW HERMAN RD, STE 100		DRWN: BGZ
TUALATIN, OR 97062		CHKD: SRR
503.563.6151 WWW.AKS-ENG.COM		AKS JOB:
		12641



DWG: 12641_C08U_G15858 | LAYOUT1