


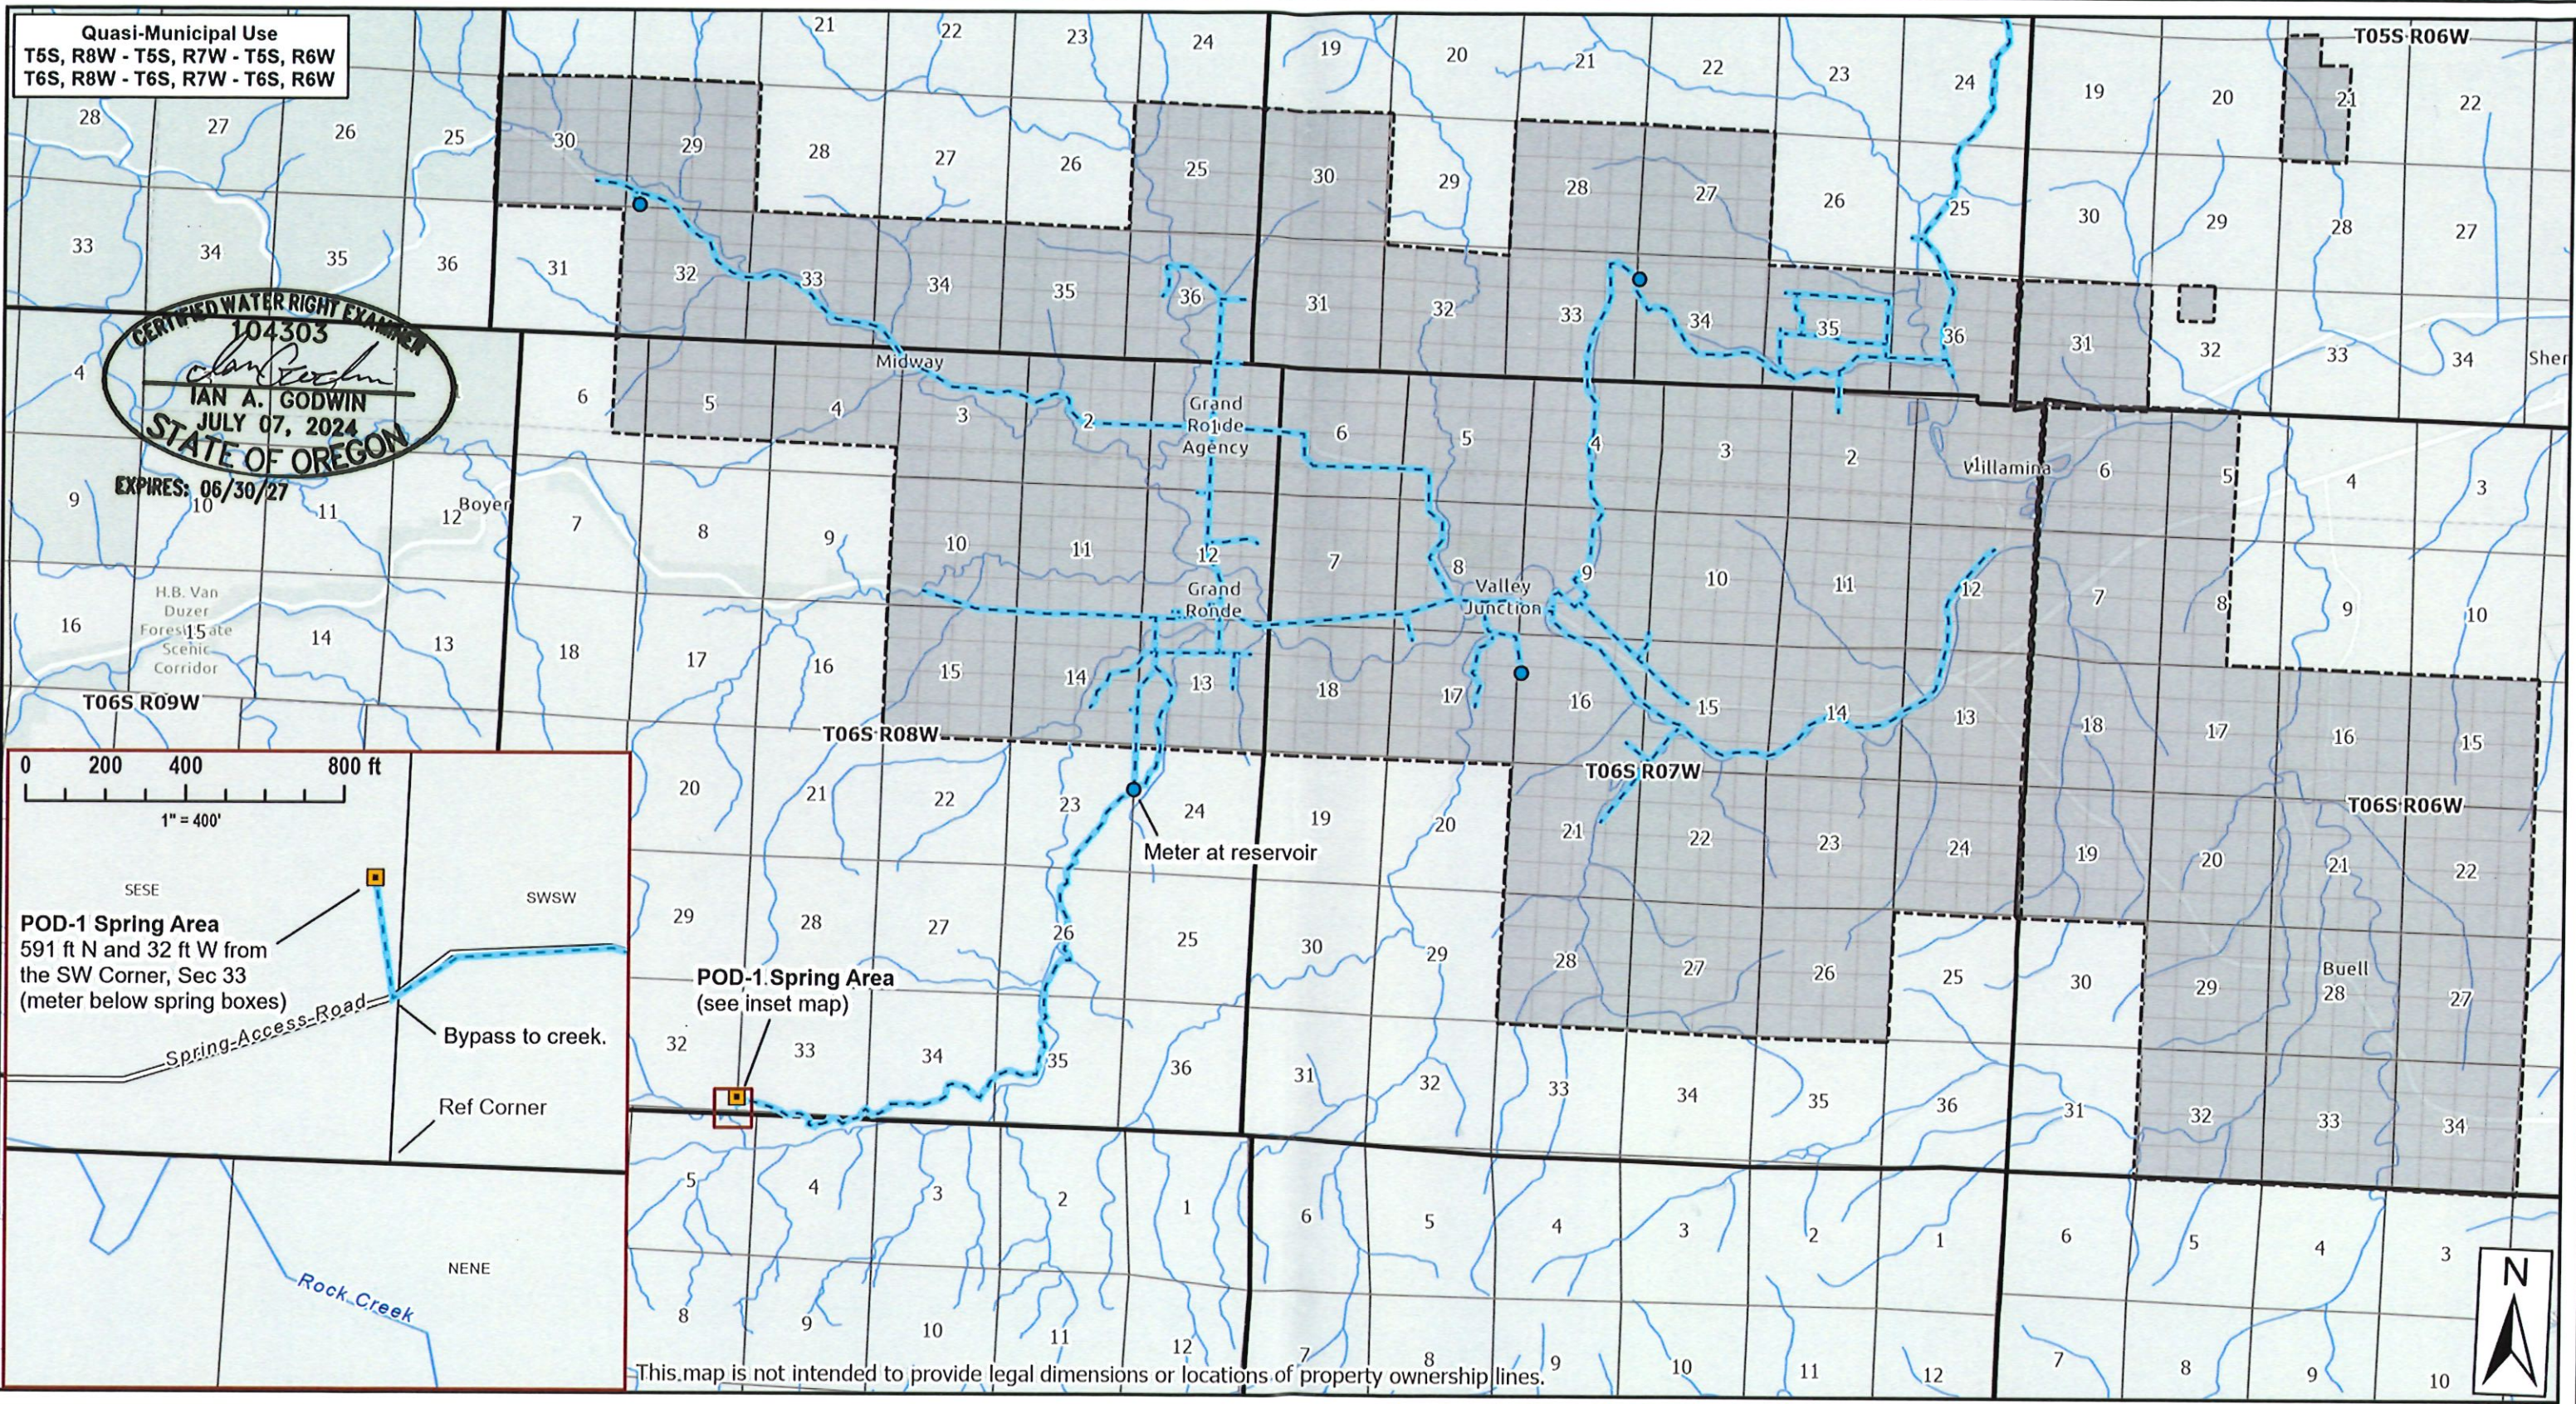

CWM-H2O 
Complete Water Management
311 B Avenue, Suite P
Lake Oswego, OR 97034
(503) 954-1326

ATTACHMENT 1 - Claim Map			
Grand Ronde Community Water Association			
App. S-52770, Permit S-41437			
1	DATE	AUTHOR	DRAFT

0 1 2 4 Miles
1 : 79,200 or 1" = 6,600'

Proj#: 2530001
Grand Ronde CWA
Grand Ronde Community Water Association
26690 Salmon River Hwy
Grand Ronde, OR 97347

 Permit S-41437 POU
 S-41437 POD
 Approx. Distribution
 Reservoir

Received
JAN 12 2026
OWRD