

North ↑

THIS MAP WAS PREPARED FOR ASSESSMENT PURPOSE ONLY

SECTION 19 T.11S. R.4W. W.M.
BENTON COUNTY



11 4 19

Well GPS
44,594755
-123,226733
875' North
1090 East
from SW
Corner Sec 19

E-RECEIVED
JAN 25, 2026
OWRD

SWSW
3.42 acres


Tax Lot 1201

To [Signature]
6/28/21

RECEIVED

JUN 29 2021

OWRD

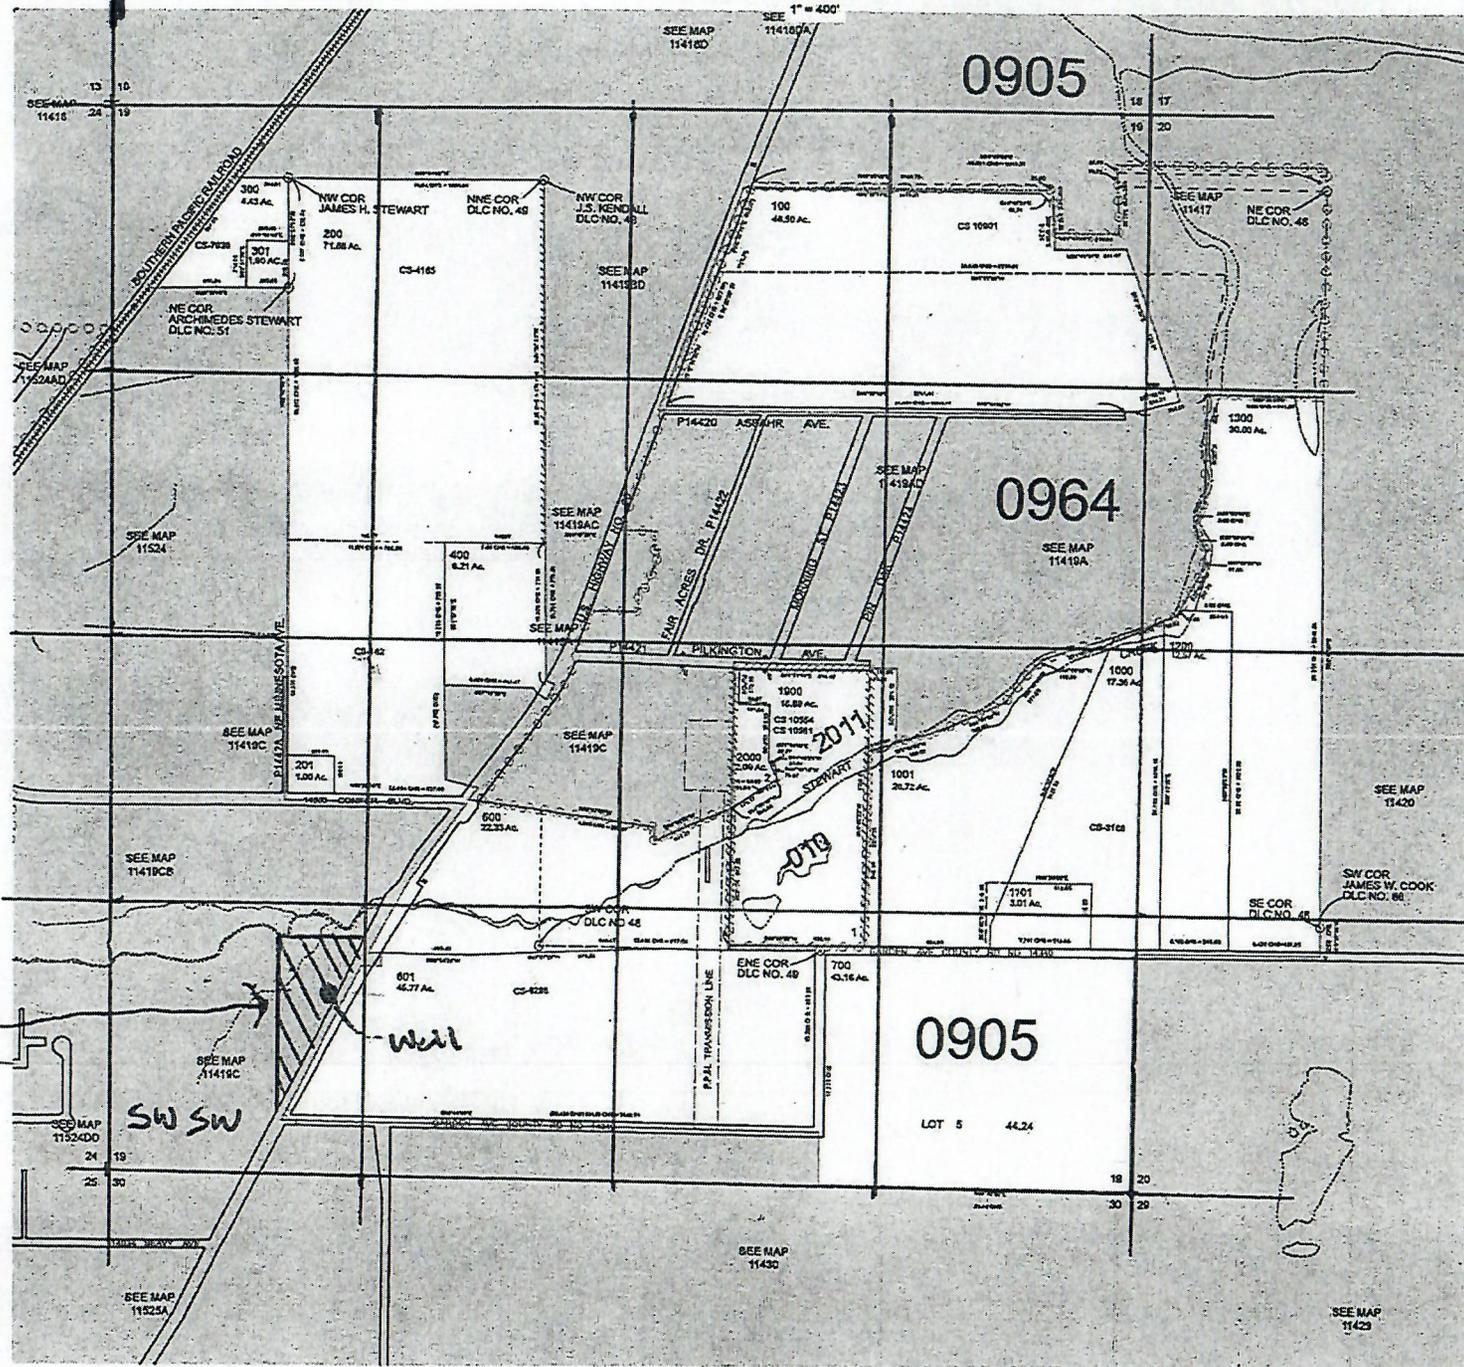

- 7/18/2018
- Cancelled Nos.
- 500
- 501
- 800
- 900
- 1000U01
- 1000U02
- 1100U01
- 1100U02
- 1400
- 1500
- 1600 THRU 1608
- 1700
- 1800 THRU 1822
- 801
- 101
- 102
- 102
- 2001
- 1801
- 1802
- 103
- 104

11 4 19