


**LEGEND**

- Point of Appropriation (POA)
- M Meter
- △ Storage Tank (200,000 and 500,000 Gallons)
- Conveyance Line
- Place of Use (POU)
- All Other Features
- City of Halsey Boundary
- Tax Lot
- Railroad
- Watercourse

**Claim of Beneficial Use Map**  
**City of Halsey**  
**Application G-13998; Permit G-18971**  
 Township 13/14 South, Range 3/4 West (W.M.)

**CERTIFIED WATER RIGHTS EXAMINER STAMP**

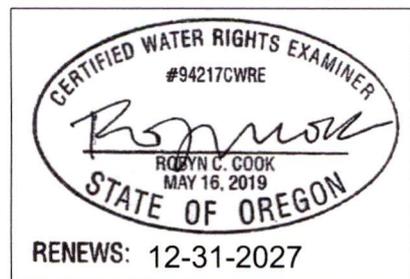

*Received*  
 JAN 15 2026  
 OWRD

**LOCATION DESCRIPTION**  
**Well 24 (LINN 64856)**  
 Located 370 feet South and 1110 feet West from E 1/4 corner, Section 1, Township 14 South, Range 4 West (W.M.)  
**Well 98 (LINN 51585)**  
 Located 328 feet South and 1095 feet West from E 1/4 corner, Section 1, Township 14 South, Range 4 West (W.M.)

**DISCLAIMER**  
 This map was prepared for the purpose of identifying the location of a water right only and it is not intended to provide legal dimensions or location of property ownership lines.

Date: November 7, 2025  
 Data Sources: BLM, ESRI, OWRD, USGS

