

T.1S. R.3E. Section 34, W.M.

Borges Road

27 | 26
34 | 35



Unnamed
Intermittent
Stream

SWNE

Well 4 (CLAC 78217) is located 80 feet north and 415 feet east from the center corner, Section 34.

Area (4.0 Acres) of nursery operations under T-13598, formerly Certificate 94783, priority date 11-26-1968.

--- Tax lot boundary

..... 3-inch portable main lines to control boxes

SE 232nd Ave

34

Portable

4.0

Well 4
(CLAC 78217)
and meter

3'

TL 1 3E 34A 800

Tillstrom Road/Market Road


SE 242nd Ave.

Received
JAN 22 2026

OWRD

This map was prepared for the purpose of identifying the location of a water right only and is not intended to provide legal dimensions or location of property ownership lines.

Scale: 1" = 400'

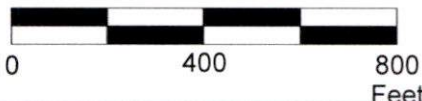

Pacific Hydro-Geology Inc.

10/2025

Claim of Beneficial Use Map
T-13598, formerly Certificate 94783

44 Acre Farms LLC
T.1S., R.3E., Section 34 W.M.