


Claim of Beneficial Use
Permit S-55248, Application S-88730

A Water Right held by Boise Cascade Wood Products LLC
Union County

Received
JAN 26 2026

OWRD

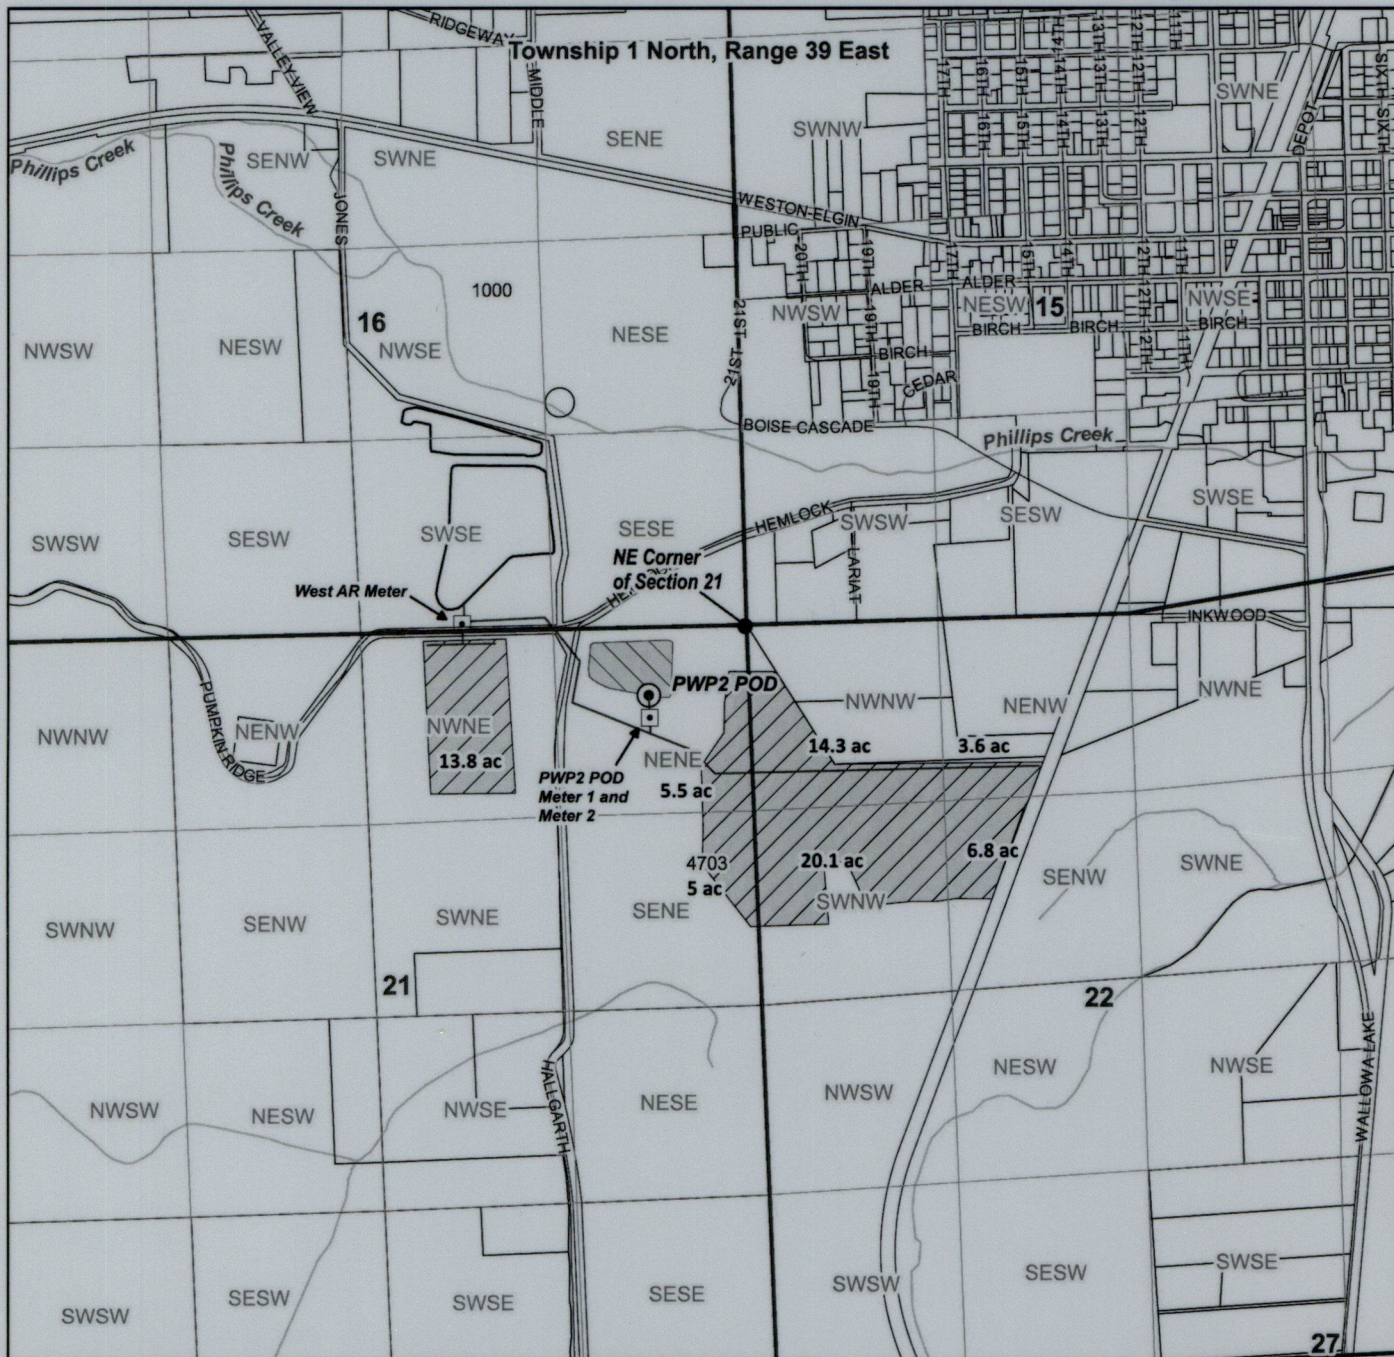


LEGEND

- Place of Use (POU) IR 69.1 ac
- Point of Diversion (POD)
- Mainline
- Flowmeter
- Reservoir PWP2 (C.96082)
- Tax Lots
- Watercourse
- Roads


POA Location Description

PWP2 POD

Located 480 feet South and 670 feet West from NE corner of Section 21 (NENE), Township 1 North, Range 39 East, W.M.

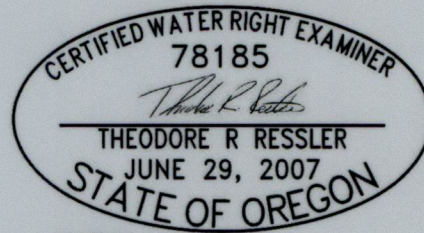

RENEW: 12-31-2026

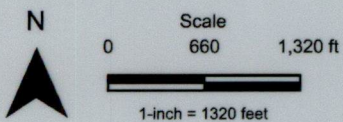

Date: 12/4/2025
Data Sources: BLM, OWRD, ODFW, USGS, Union County.
Disclaimer: This map is not intended to provide legal dimensions or property ownership lines.

