

LEGEND

—	SECTION LINE
— — —	1/4 1/4 LINE
— — — —	TAX LOT LINE
— — — — —	CREEK
— — — — — —	BURIED PIPE
— — — — — — —	ROAD
22 22 22 22	SECTION CORNER
TL 0000	TAX LOT NUMBER
W	POA (WELL)
■	TRANSFER T-13648 IRRIGATED LANDS
◆ 35.0 SWSE	IRRIGATED LANDS
◆	1/4 1/4 SECTION


NOTES:

1. THIS MAP WAS PREPARED FROM FIELD MEASUREMENTS, NAIP 2025 AERIAL PHOTOGRAPH, KLAMATH COUNTY TAX MAPS, AND OREGON GLO MAPS.
2. THE PURPOSE OF THIS MAP IS TO IDENTIFY THE LOCATION OF THE WATER RIGHT ONLY, AND IS NOT INTENDED TO PROVIDE DIMENSIONS OR LOCATION OF PROPERTY LINES.
3. DATE OF PRIORITY FOR THIS WATER RIGHT IS MARCH 3, 1977.

WELL LOCATION:

WELL 3 (KLAM 10082): T37S, R10E, W.M., SEC. 19, SW1/4 NE1/4; 1630 FEET SOUTH & 2220 FEET WEST FROM NE CORNER, SECTION 19.

Received
JAN 23 2026
OWRD

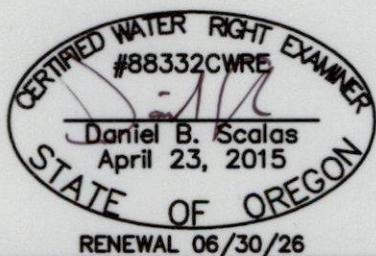

ADKINS
ENGINEERING & SURVEYING

1435 ESPANADE AVENUE, KLAMATH FALLS, OR 97601

SERVING S. OREGON & N. CALIFORNIA

1/21/2026

ENGINEERING • SURVEYING • PLANNING • TESTING

3431-02

CLAIM OF BENEFICIAL USE AND FINAL PROOF MAP

FOR
EDGEWOOD RANCH INC.
T37S, R10E, SEC. 19, WM
KLAMATH COUNTY, OREGON
TRANSFER T-13648