



Water Right T26S R05W Section 26

Oregon

12/8/2025

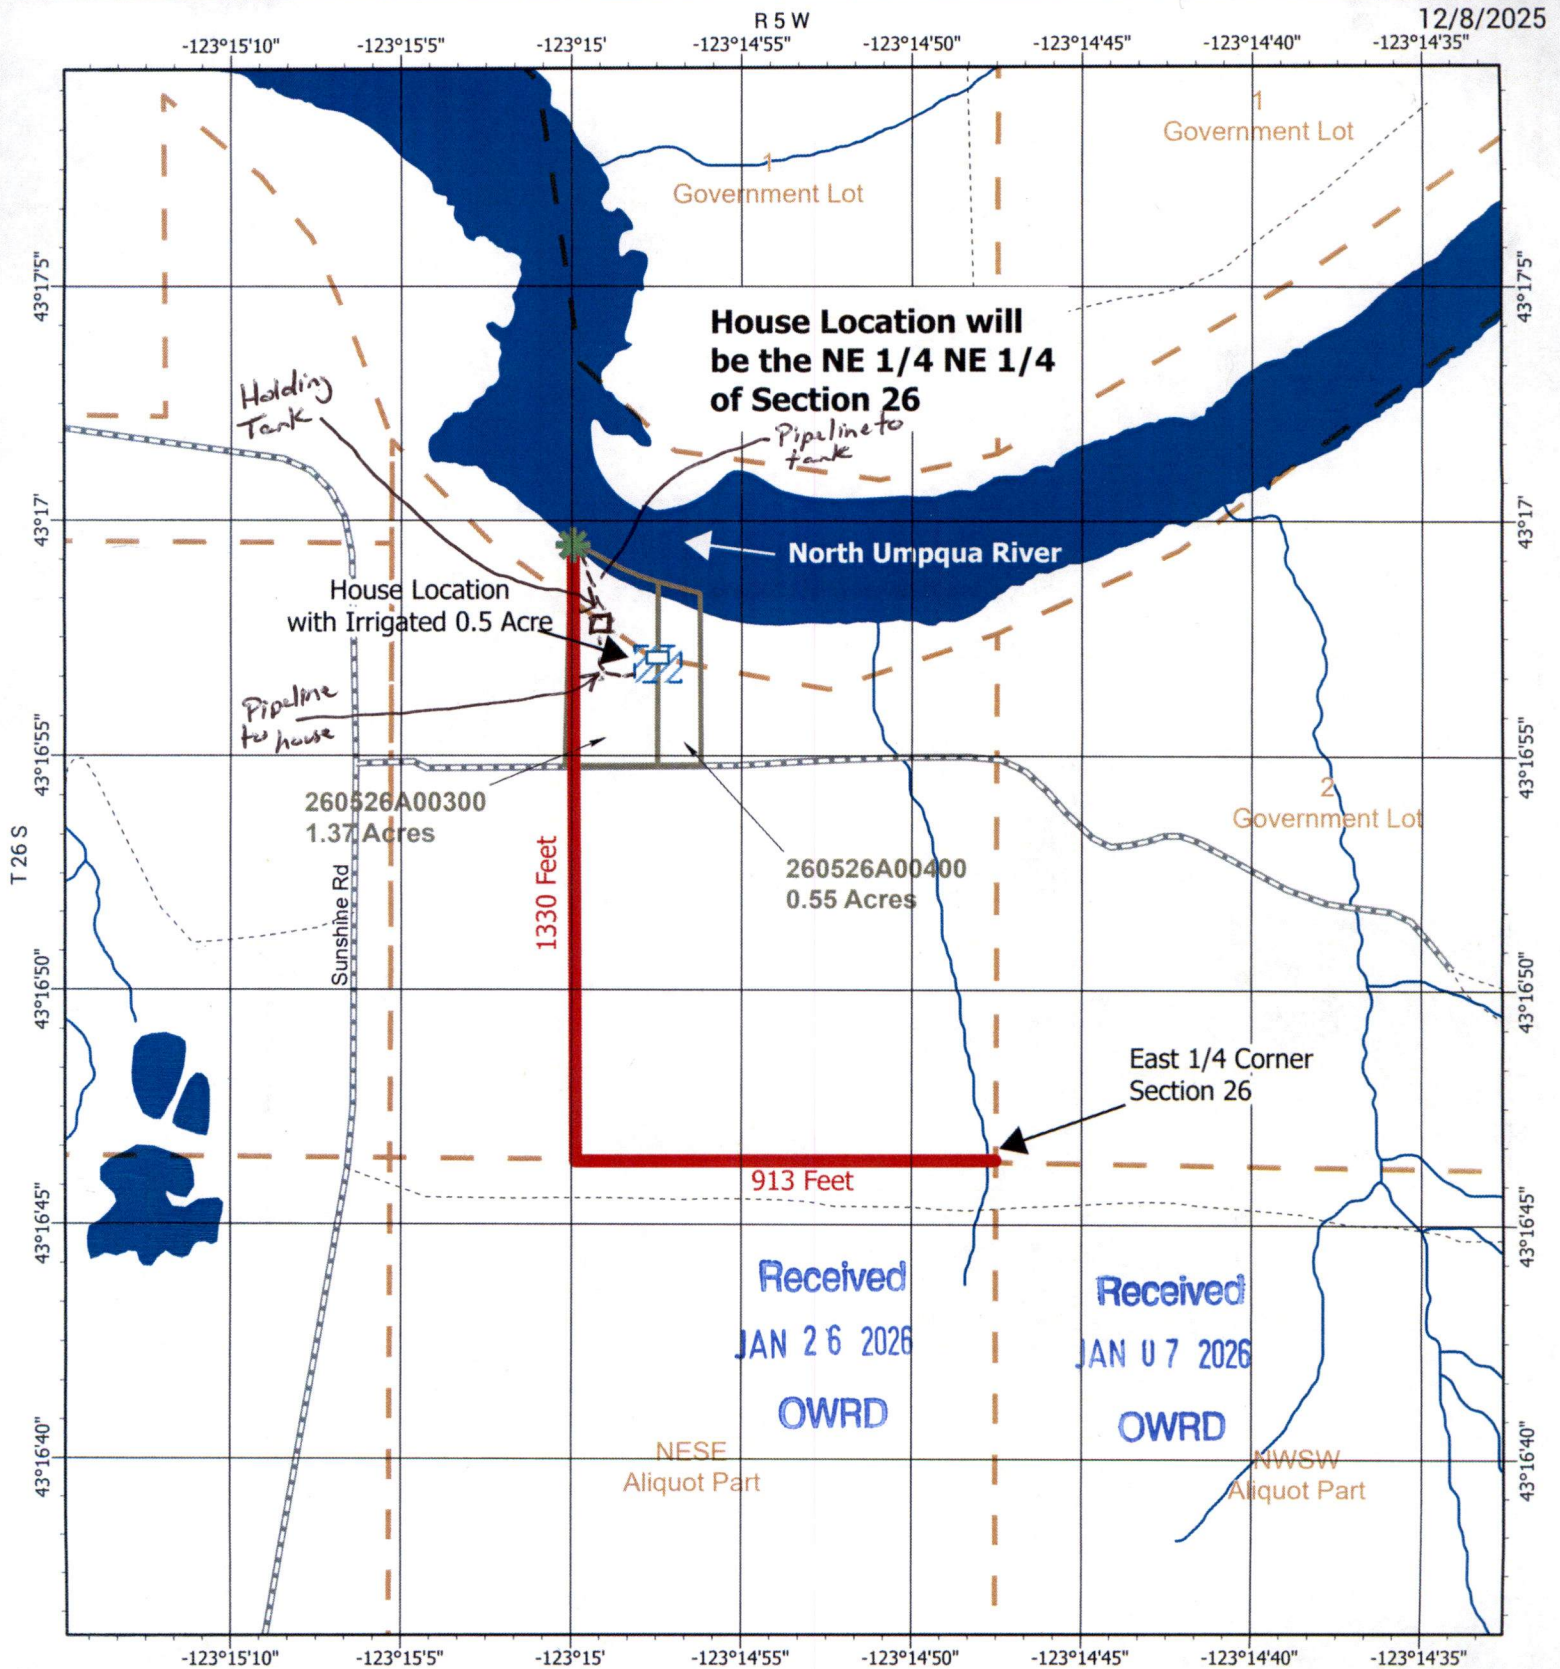

Quarter/Quarter Sections	Major River Area	Other Road
Stream	district_TR	Tax Lot
Waterbody	Road Ownership	Diversion Point
	County Road	

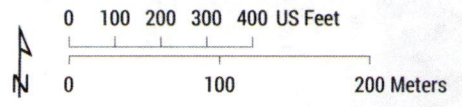

Received
JAN 26 2026
OWRD

Received
JAN 07 2026
OWRD