


Claim of Beneficial Use Map Transfer T-8652 KC Property Holdings, LLC

T 35 S, R 1 W
Section 16

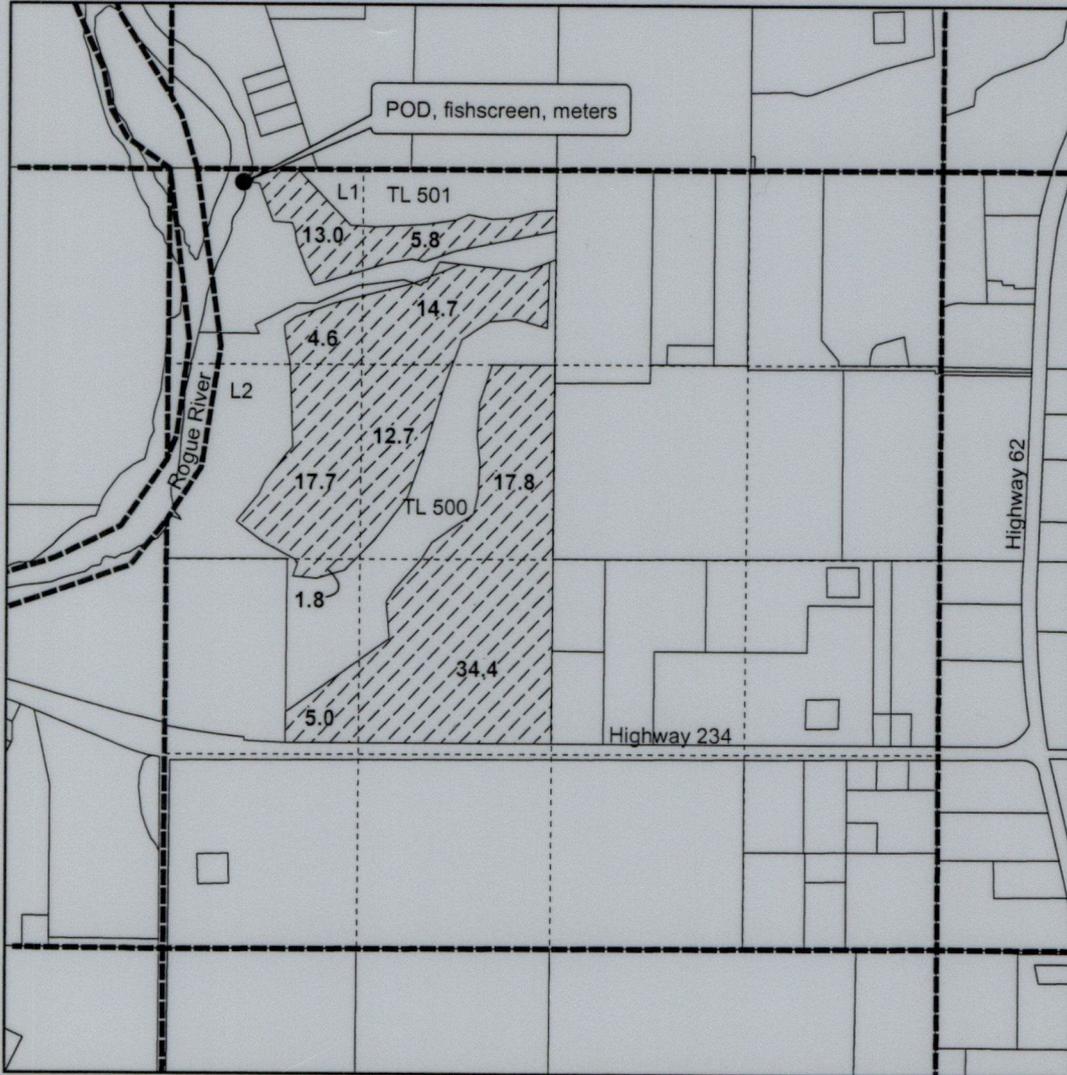


POD located 48 ft South and 120 ft East from the NW, Cor of Section 16, T 35 S, R 1 W, WM.

Legend

-  Place of Use by record 127.5 ac
-  Point of Diversion (POD)
-  Section Line
-  Quarter Quarter Line

N

1 inch = 1,320 feet

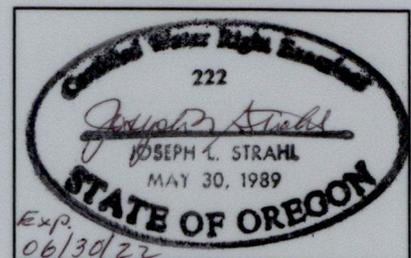

Note: This map is not intended to provide legal dimensions or location of property ownership lines.

Received
JAN 27 2026
OWRD