
T.4S. R.5W. W.M.

YAMHILL COUNTY, OREGON

Received by OWRD
JAN 30 2026
Salem, OR

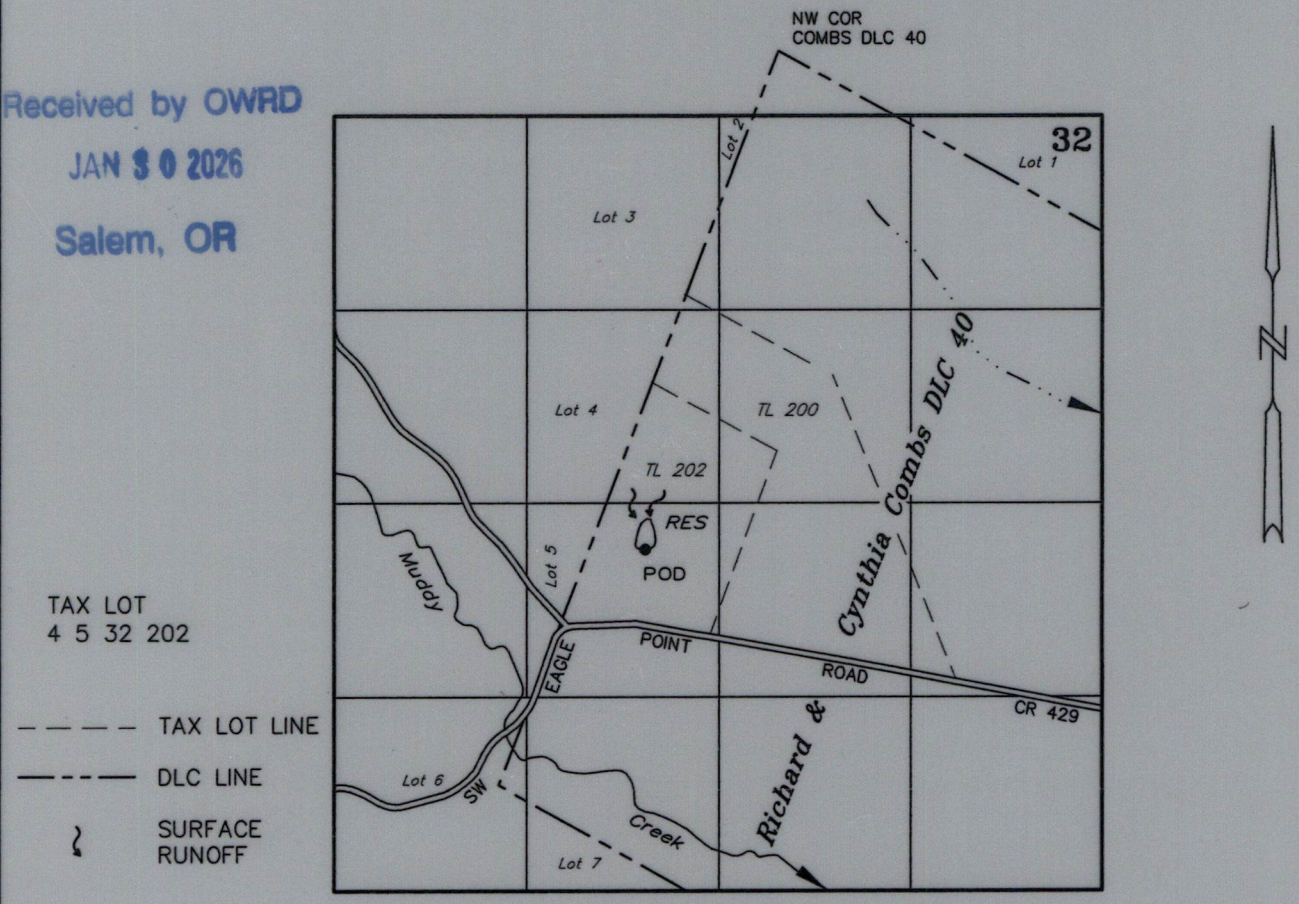

RESERVOIR POD: 3,395' SOUTH AND 935' WEST OF THE NW COR, COMBS DLC 40

CLAIM OF BENEFICIAL USE

UNDER

Application No. R-84860 Permit No. R-13294

James Neal

SEPTEMBER 18, 2025

SCALE: 1" = 1320'

Certified Water Right Examiner
#208 WRE
Corbey Boatwright
Corbey Boatwright
May 30, 1989
STATE OF OREGON

NOTE: This map is for the purpose of identifying the location of water rights and has no intent to dimension or locate property ownership lines.

Renewal Date: 12-31-2027