


# T8S R46E WM

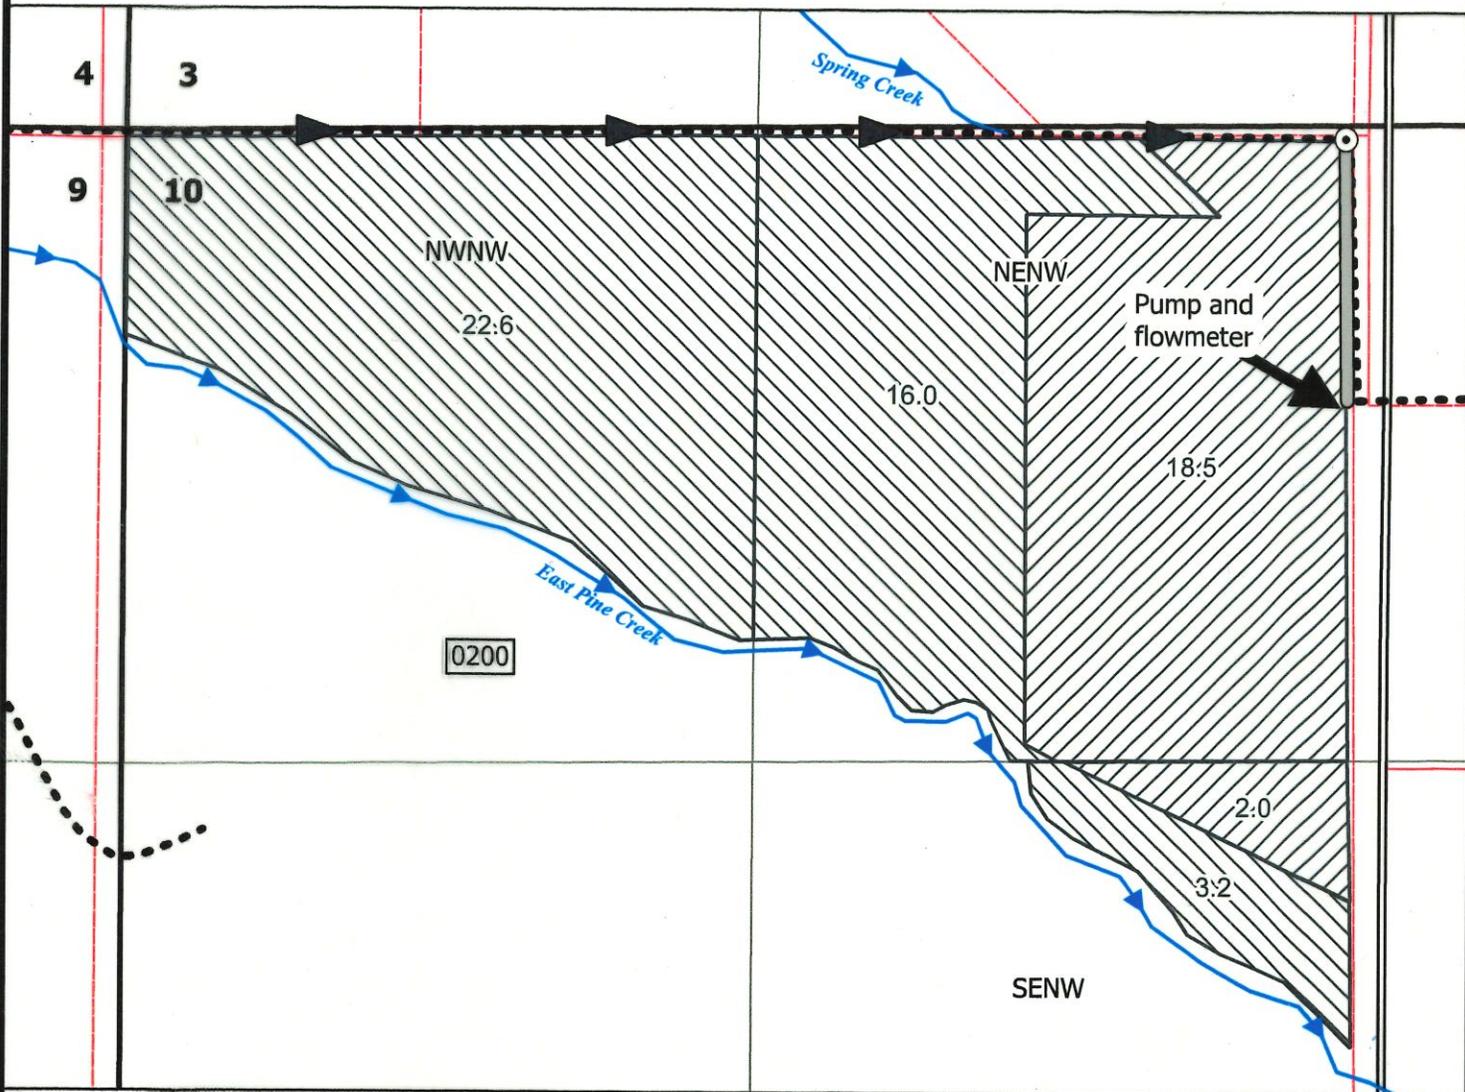

## LEGEND

Place of Use

 IR

 IS

 Additional POD


 Drainage Ditch

 12" Pipe

 Baker County Taxlot Boundary 0200



Received  
JAN 29 2026  
OWRD

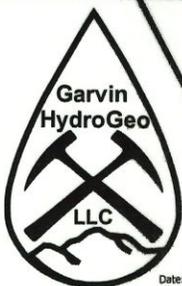

## Transfer T-14424 Claim of Beneficial Use Map Baker County, OR

Prepared on behalf of Barry DelCurto

1 inch = 400 feet



Note:

This map is not intended to provide legal dimensions or locations of property ownership lines.

APOD: 5' S and 45' W of the N 1/4 corner of Section 10

The flow measurement device located approximately 675' S of the POD

Sources: Drainage ditch and Spring Creek