


- PP 2001-19
- 1. S31°56'03"W 14.84'
- 2. N75°12'46"W 12.86'
- 3. N64°53'38"W 40.22'
- 4. N41°00'47"W 11.27'
- 5. N22°56'52"E 23.2'
- 6. N00°19'53"W 75.91'
- 7. N29°06'22"W 88.99'
- 8. N13°59'17"W 48.97'
- 9. N82°17'48"W 49.14'
- 10. S11°58'42"E 22'
- 11. S88°18'07"E 44.39'
- 12. S24°08'42"E 69.1'
- 13. S2°05'22"W 37.32'
- 14. S48°11'04"W 21.19'
- 15. S51°11'32"W 36.82'

POD = ●  
POD located 990' N and  
335 Pt west from center  
of section 14.

Tax lot = 500

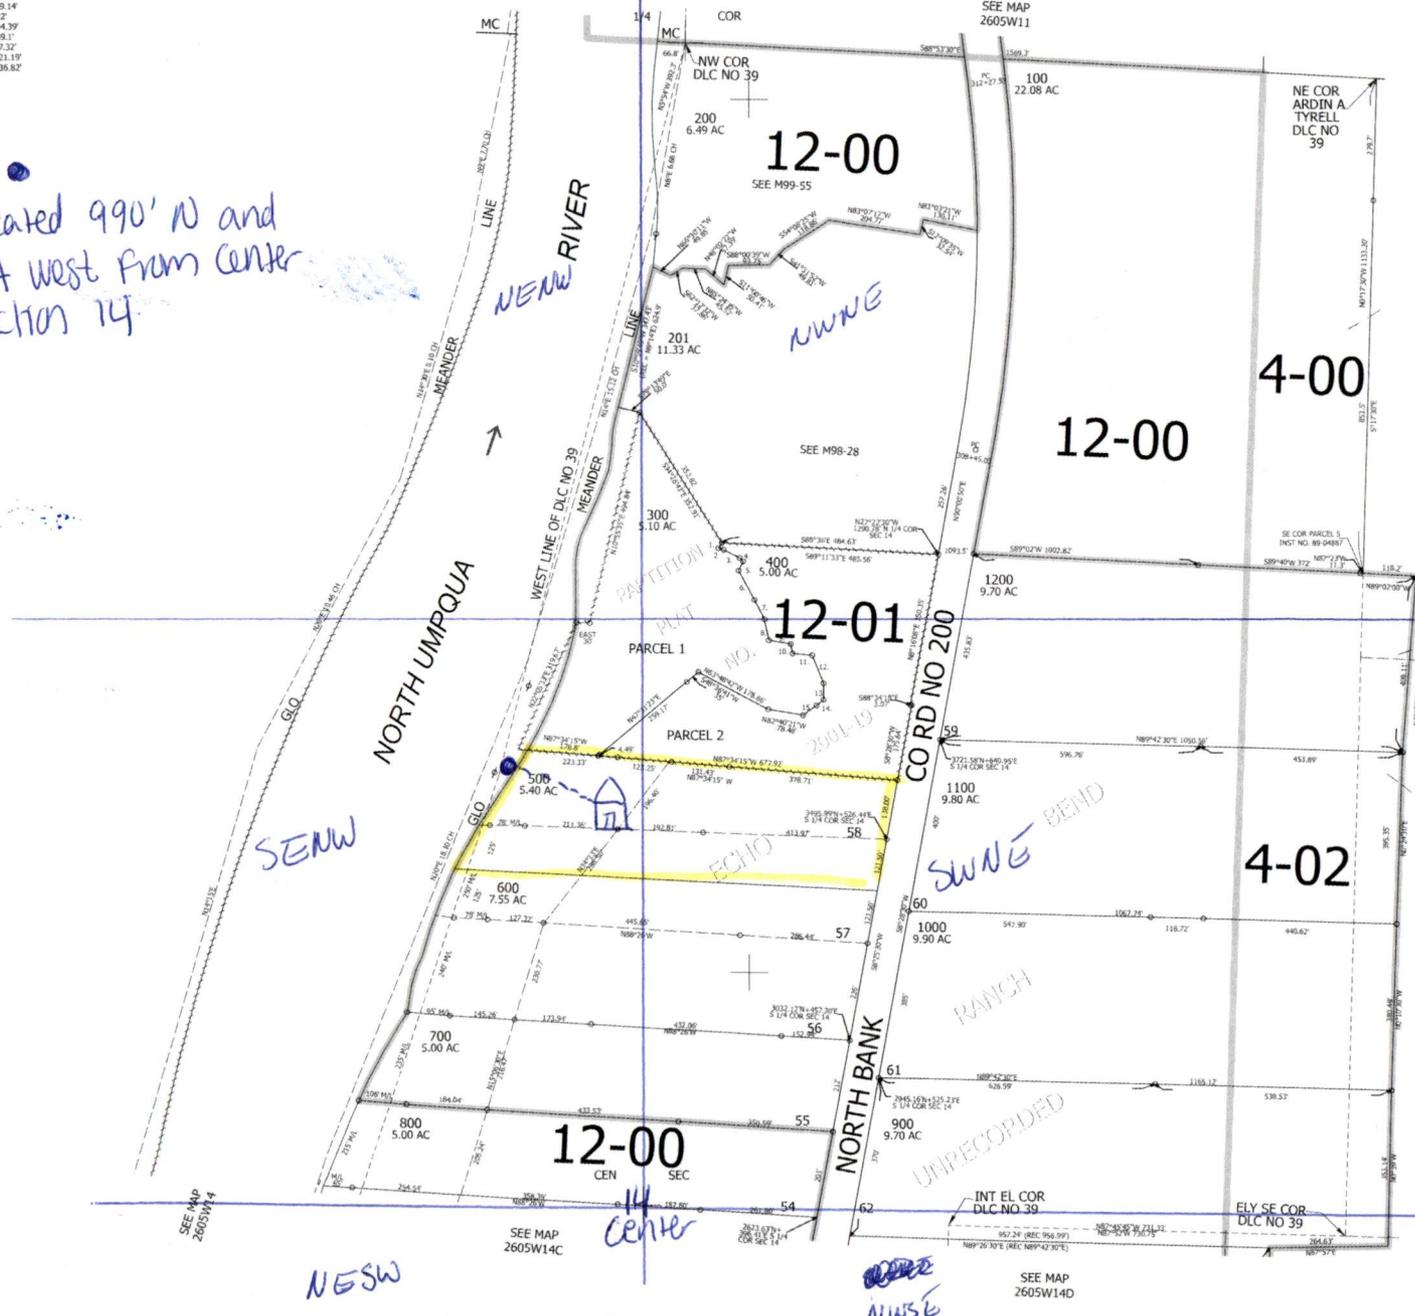

Received  
OWRD  
FPR 0 2 2026

Received  
JAN 15 2026  
OWRD