


Claim of Beneficial Use - Silke Tower Properties, LLC


Application S-86013, Permit S-54150

Township 19S, Range 12W, W.M.

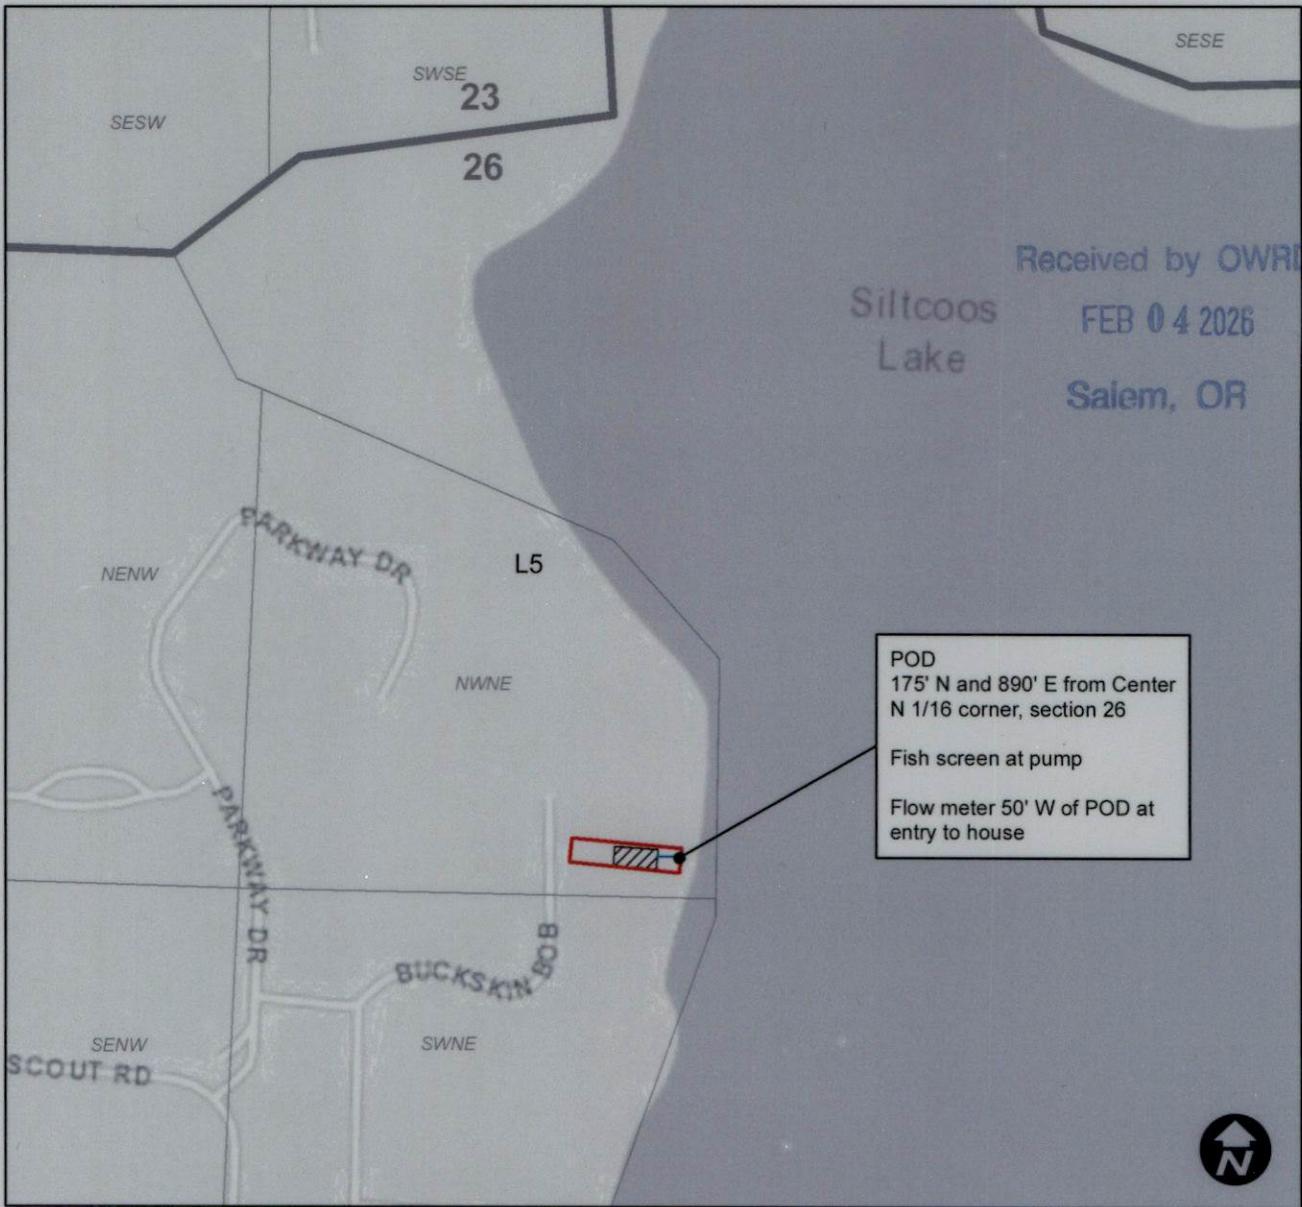

Received by OWRD
 FEB 04 2026
 Salem, OR

POD
 175' N and 890' E from Center
 N 1/16 corner, section 26
 Fish screen at pump
 Flow meter 50' W of POD at
 entry to house

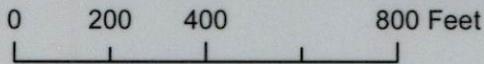

This map is not intended to provide legal dimensions or locations of property ownership lines.

Legend

-  POU
-  Supply Line
-  Taxlot 5300

CERTIFIED WATER RIGHT EXAMINER
30680
William E. McGill
WILLIAM E. MCGILL
MAY 3, 2011
STATE OF OREGON
EXPIRES: 12-31-2026