


T.3S. R.1E. Section 16, W.M.

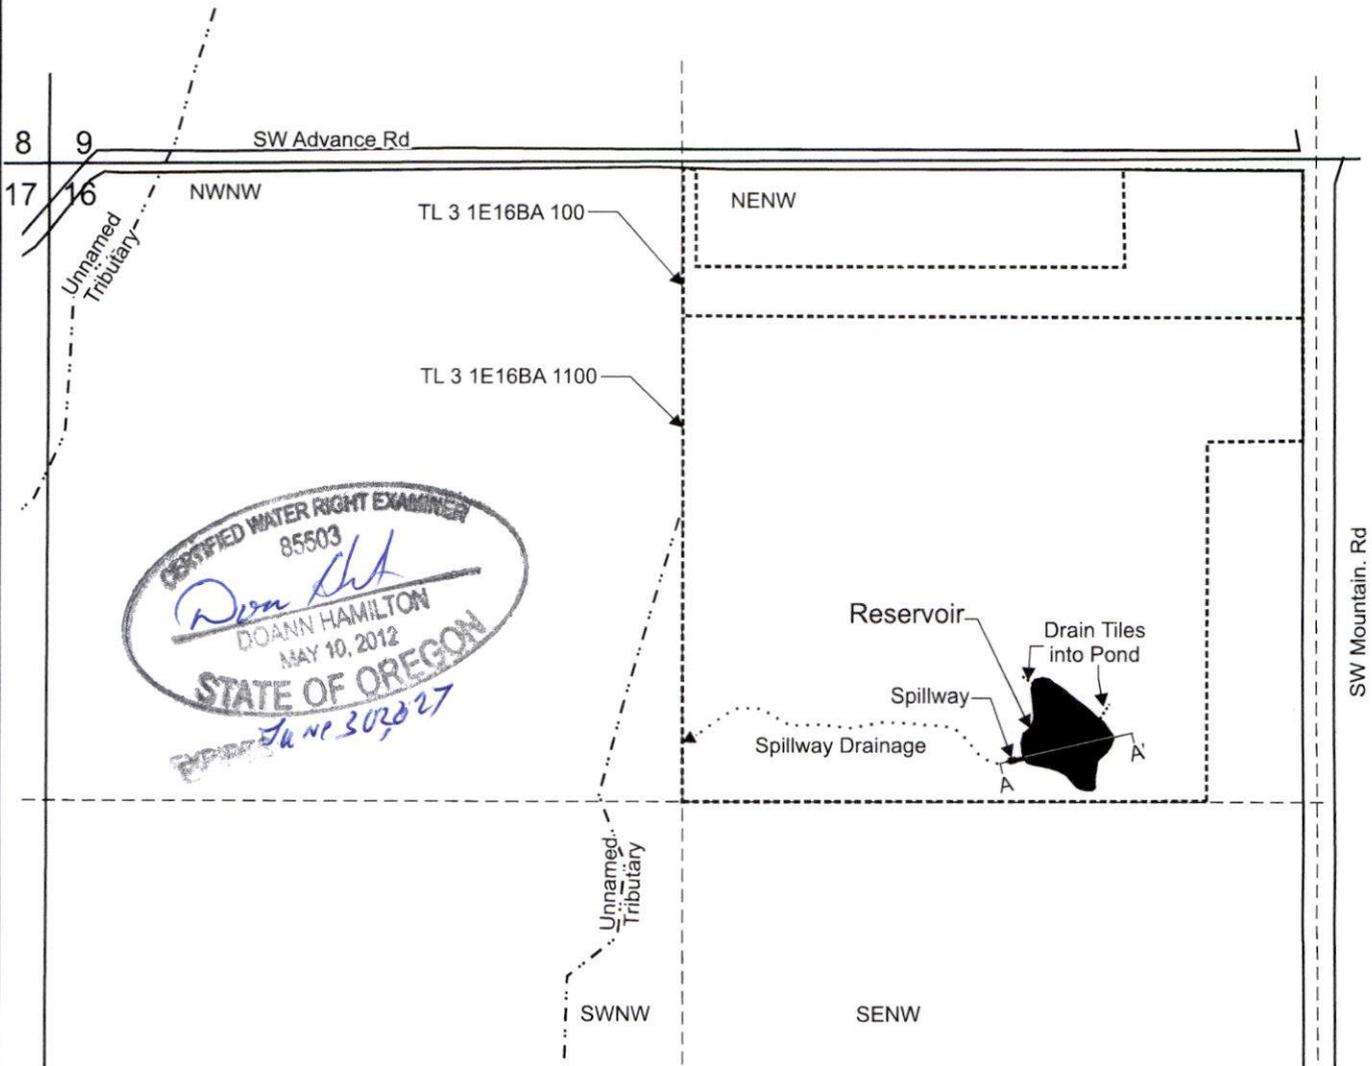


Reservoir center is located 1,185 feet south and 2,100 feet east from the NW corner, Section 16.

Area (0.58 Acres) impounded by Application R-89430, Permit R-15643.

- Tax lot boundary
- Drain Tiles into pond
- Spillway drainage path

A A' See additional cross-section figure

Scale: 1" = 400'

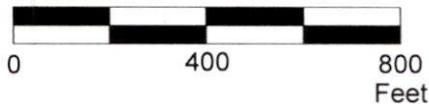

This map was prepared for the purpose of identifying the location of a water right only and is not intended to provide legal dimensions or location of property ownership lines.

Received by OWRD

FEB 04 2026

Salem, OR



Claim of Beneficial Use Map
Application R-89430, Permit R-15643

Shortland Golf Club LLC c/o Mike Fritz
T.3S. R.1E. Section 16, W.M.

 WILL MCGILL SURVEYING LLC

01/2026

ShortlandR-89430COBUMap.cdr