



Property

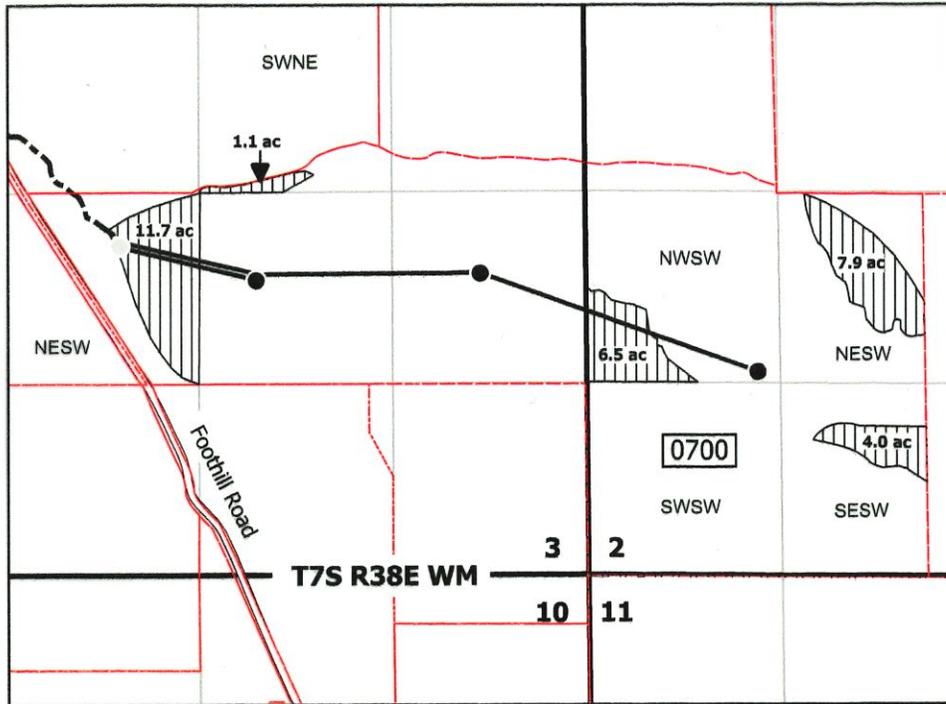


POD

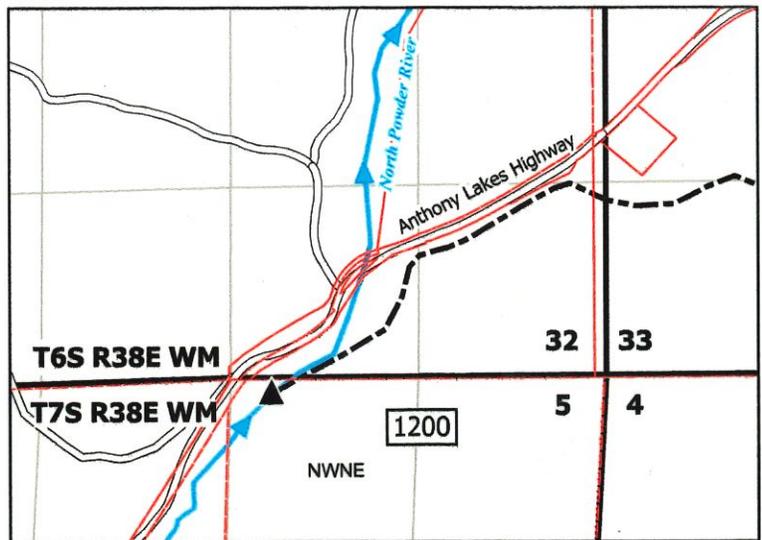

LEGEND


- Irrigated Area
- Baker County Taxlot Boundary 0100
- Center Pivot Pad
- Bulge in the System
- Mainline
- Hutchinson Hillside Ditch
- Point of Diversion

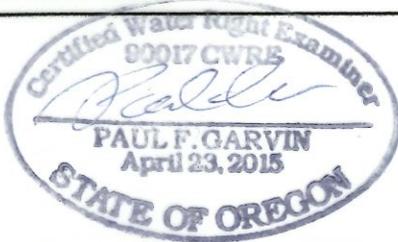

Received

FEB 03 2026

OWRD

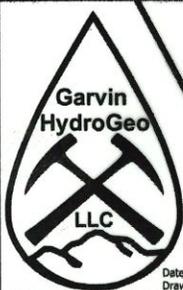

**Transfer T-13604
Claim of Beneficial Use Map
Baker County, OR**

Prepared on behalf of Dale Bingham

1 inch = 1,320 feet



Notes:

POD: 104' S & 2,380' W from the NE Corner of Sec 5

This map is not intended to provide legal dimensions or locations of property ownership lines.