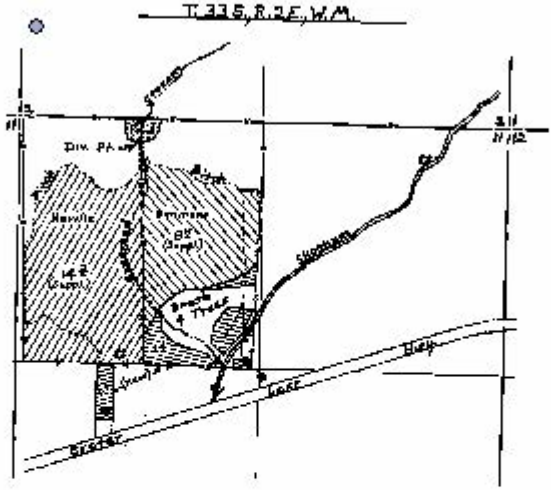

RECEIVED
JAN 26 1962
STATE ENGINEER
SALEM, OREGON

FINAL PROOF SURVEY
UNDER

Application No. 30916 Permit No. 24267
IN NAME OF

E. W. Simmons & David Neville

Surveyed Nov. 14, 1961, by R.L. Hendrix

Scale: 8" = 1 mile