


Claim of Beneficial Use - Kizer - Transfer T-14164

Township 19S, Range 3W, W.M.

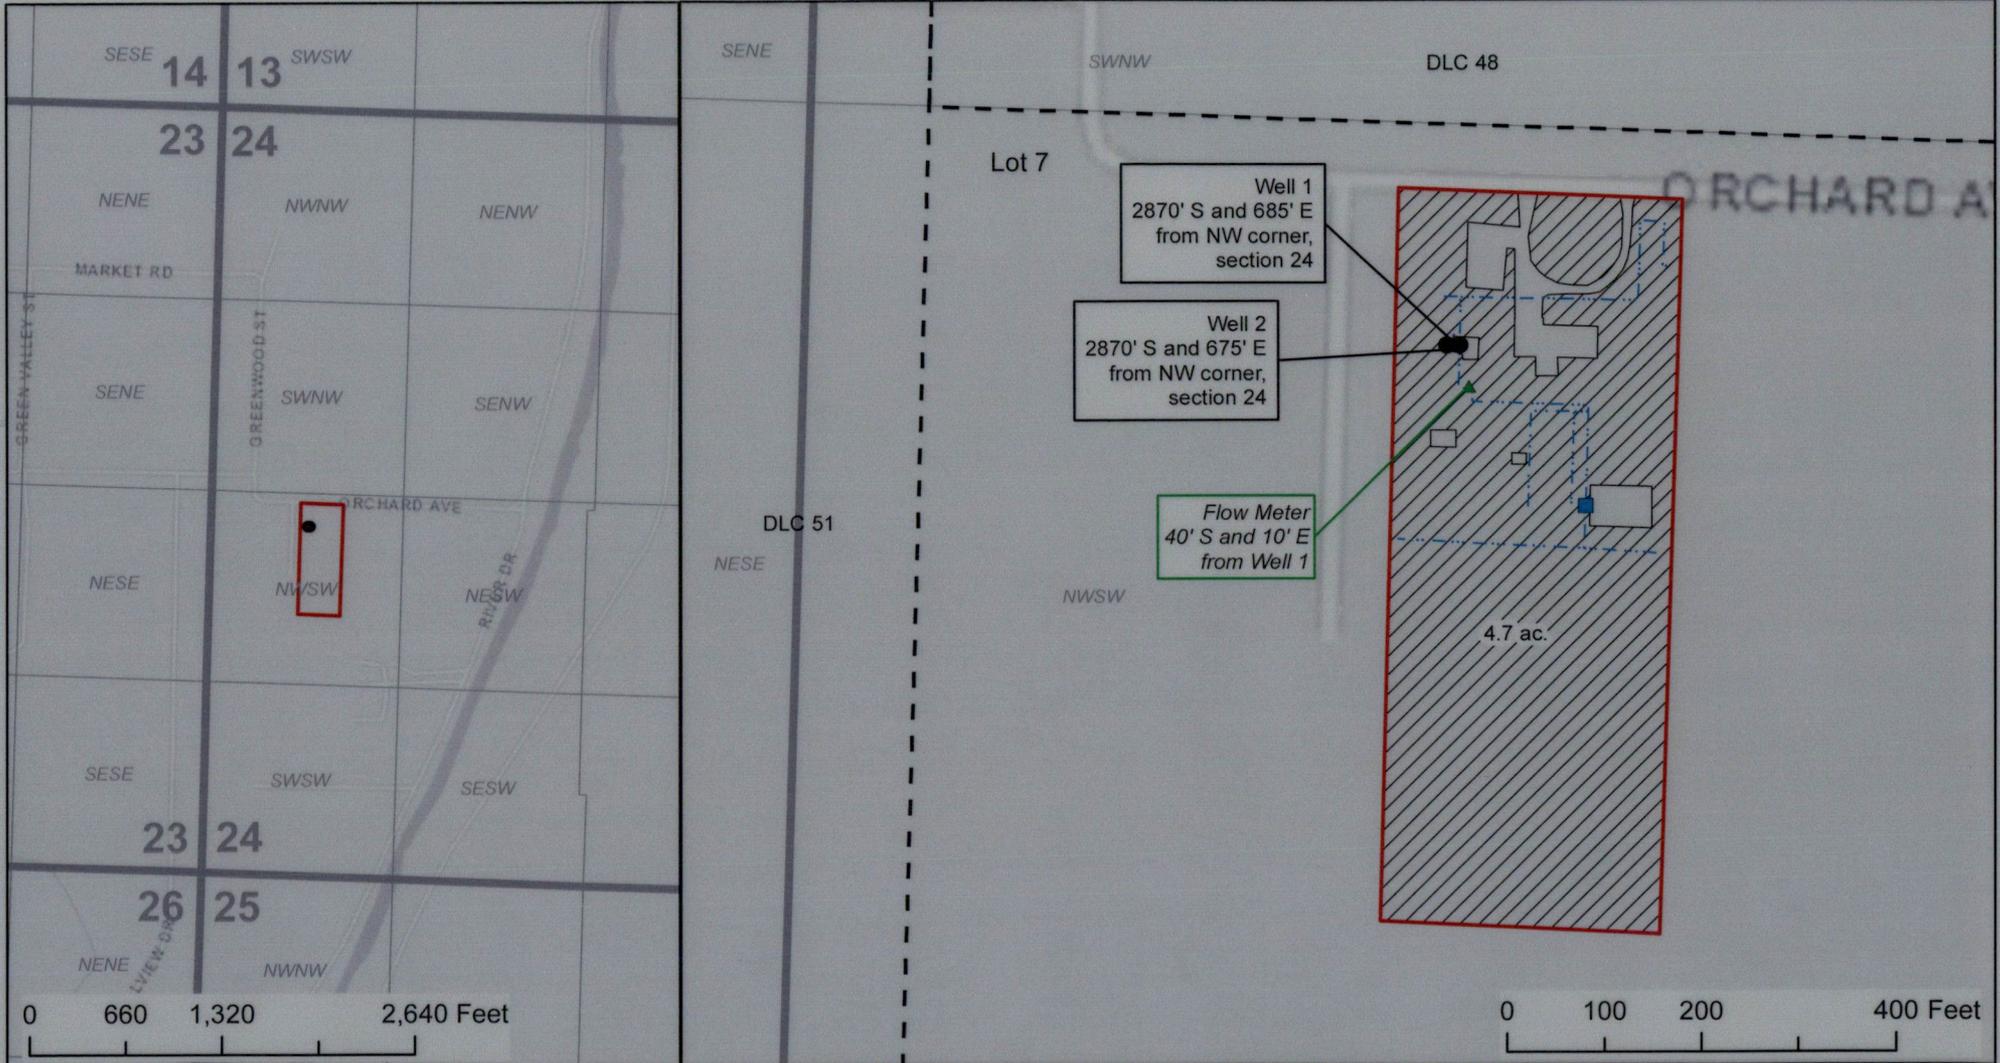

This map is not intended to provide legal dimensions or locations of property ownership lines.



EXPIRES: 12-31-2026

Legend

- POU
- Mainline
- Taxlot 1706
- DLC

Received by OWRM
 FEB 04 2026
 Salem, OR

WILL MCGILL SURVEYING LLC