


Claim of Beneficial Use - Knee Deep Cattle Co./Mike Stevenson
 Transfer T-13782

Township 16S, Range 3W, W.M.

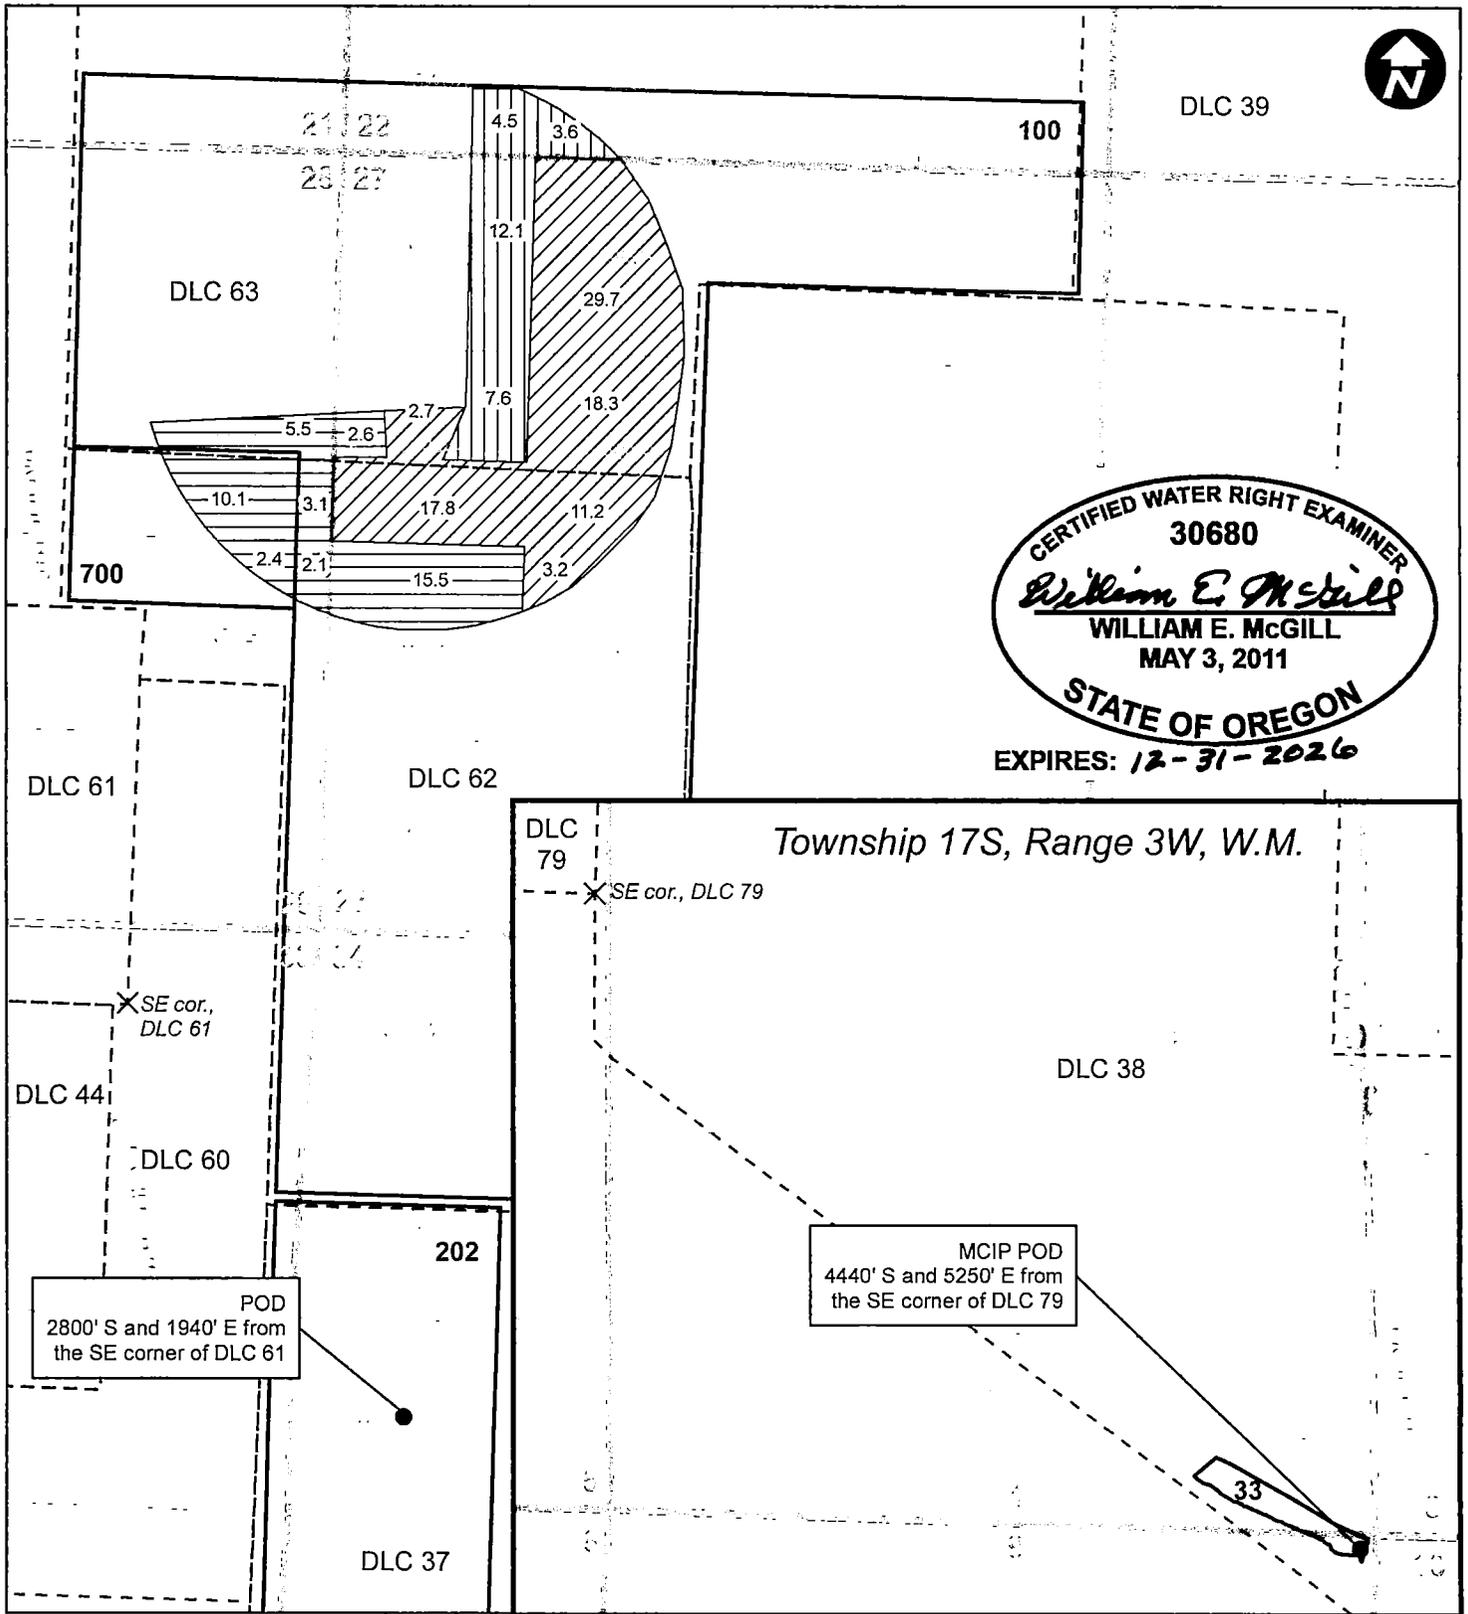

CERTIFIED WATER RIGHT EXAMINER
 30680
William E. McGill
 WILLIAM E. MCGILL
 MAY 3, 2011
 STATE OF OREGON
 EXPIRES: 12-31-2026

Township 17S, Range 3W, W.M.

Legend

- T-13782 POU (C86338 CN)
- T-13782 POU (C80835 CN)
- T-13782 POU (C91761 CN)
- DLC
- Taxlot

This map is not intended to provide legal dimensions or locations of property ownership lines.

