


COBU MAP

(Application R-84459, Permit R-15535)

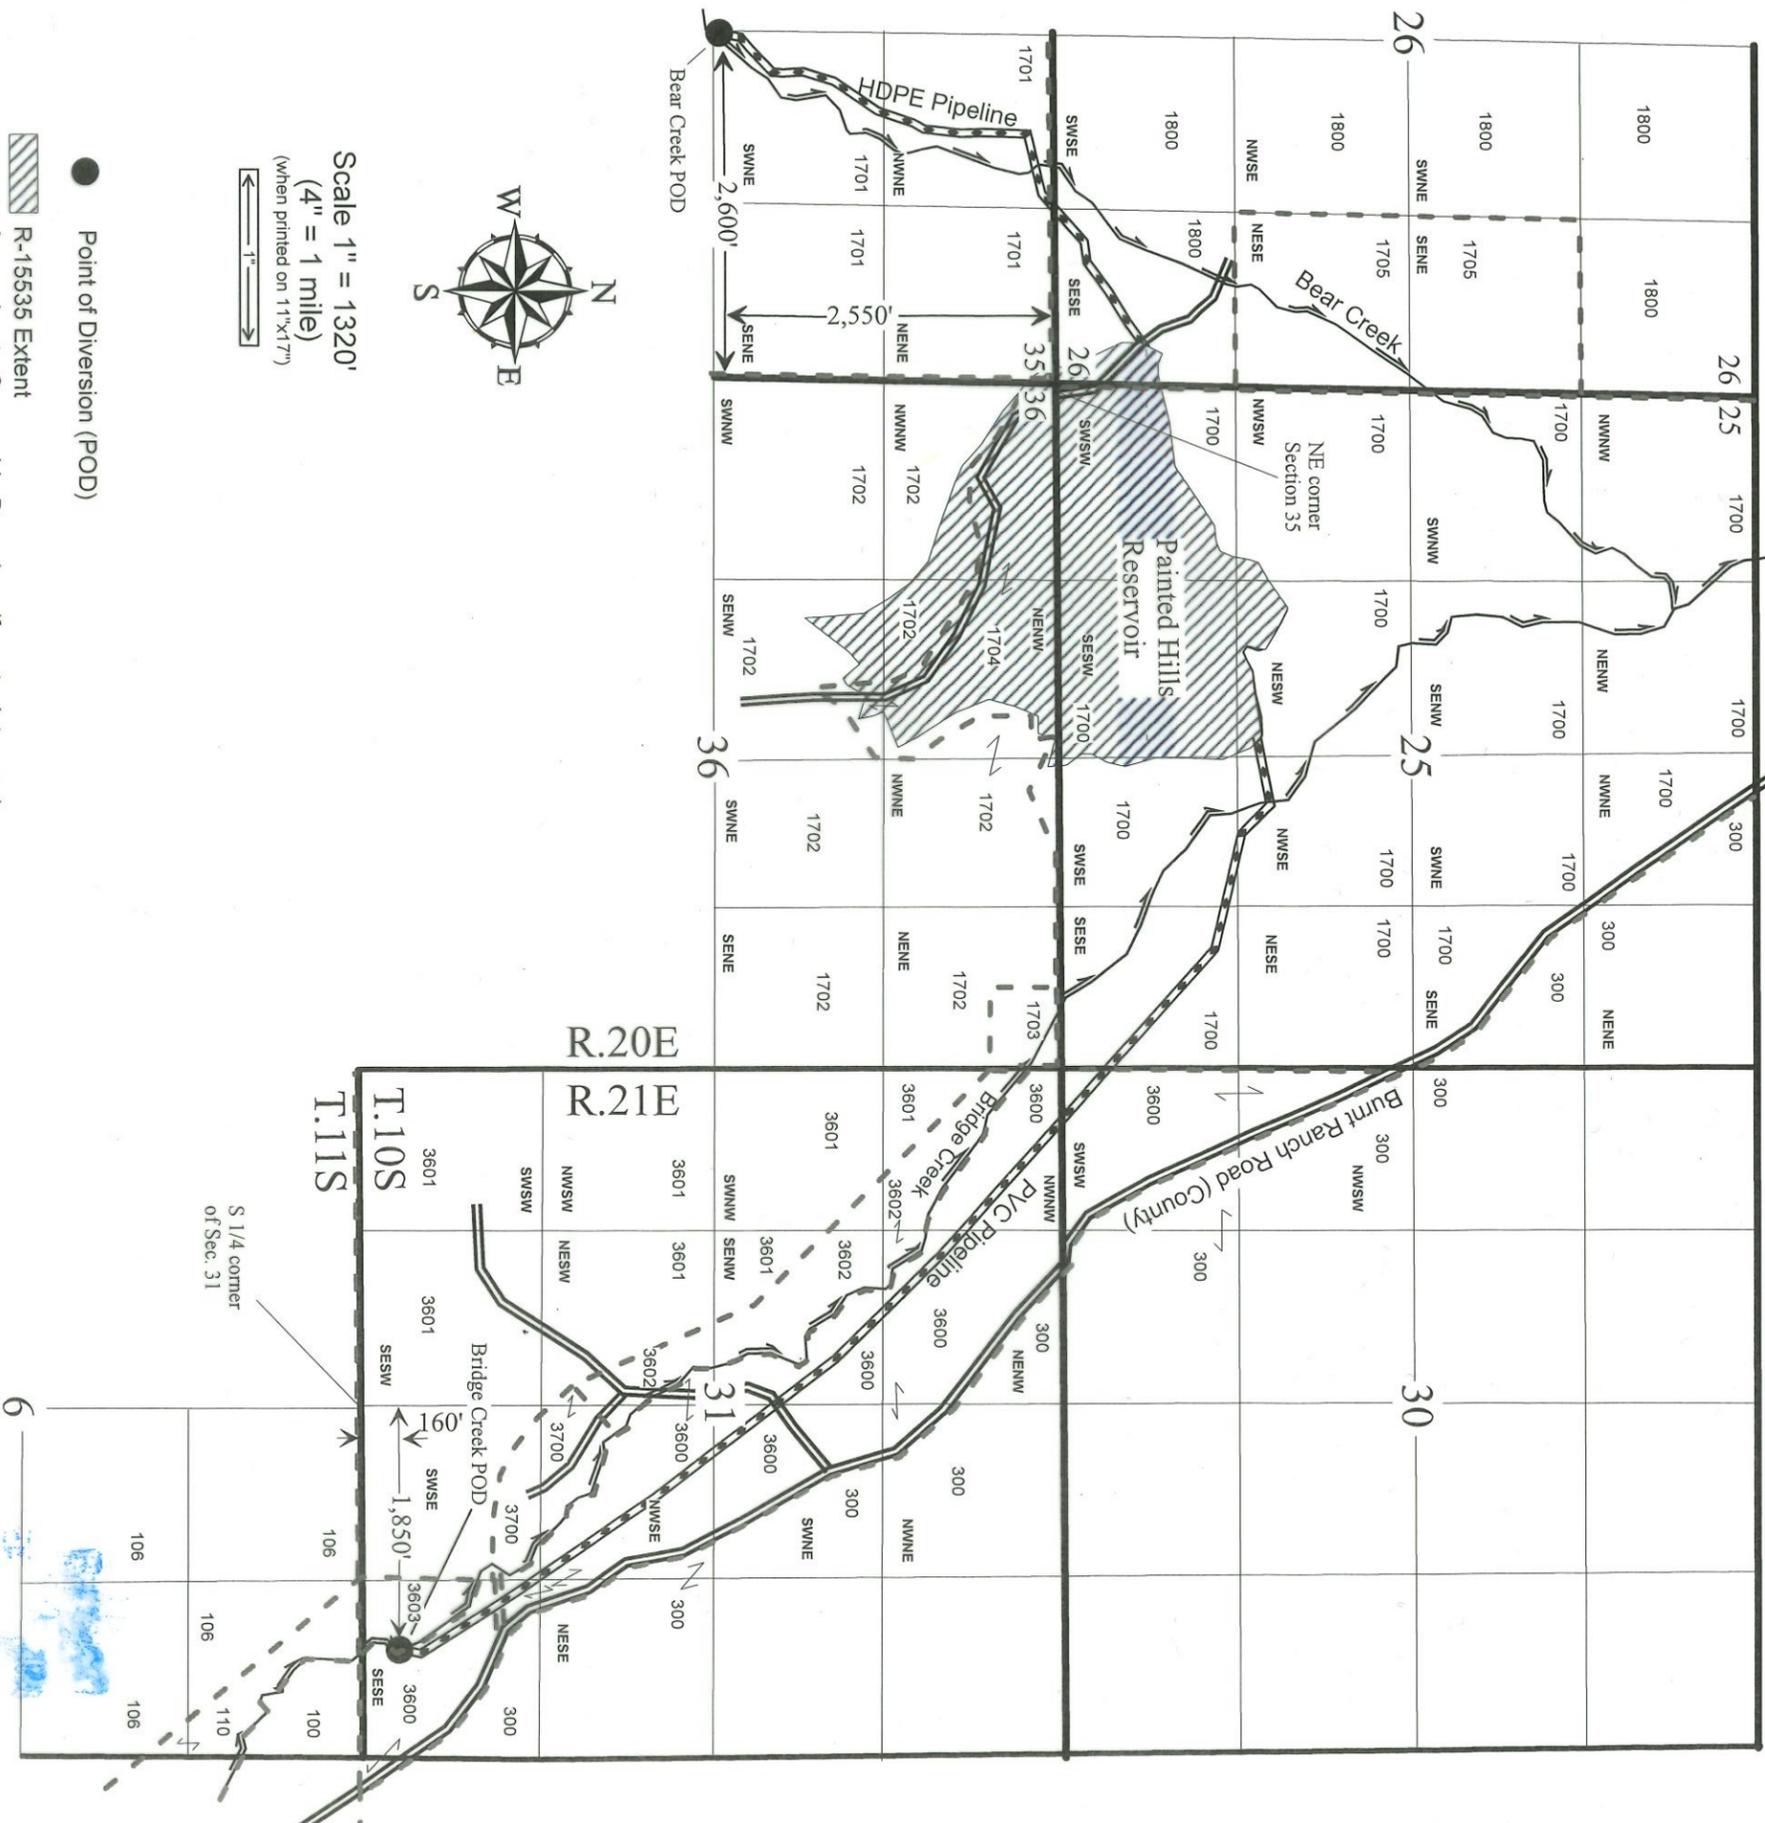

Scale 1" = 1320'
(4" = 1 mile)
(when printed on 11"x17")



- Point of Diversion (POD)
- ▨ R-15535 Extent
- - - Approximate Ownership Boundary (from taxlot maps)
- == Pipeline
- == Road
- ~ Creek

This map is for the purpose of locating a water right only and is not intended to provide legal dimensions or locations of property ownership lines.

CERTIFIED WATER RIGHT EXAMINER
 72665
 GABRIEL M. WILLIAMS
 JULY 10, 2018
 STATE OF OREGON

Received
FEB 03 2026

DMPD

DRAWING: R-11.1	DRAWN BY: GMM	PROJECT: COBU MAP R-15180	DRAWING STATUS: DRAFT
SHEET TITLE: COBU MAP		PROJECT LOCATION: MITCHELL, OREGON	DATE: 9/22/25
CLIENT: Bridge Creek Ranch, LLC		 RSI Resource Specialists Inc. 20340 EMPIRE AVE, STE E8 BEND, OR 97703 (541) 771-6911 gabe@RSIengr.com	REVISION: 1
			DATE: