


COBU MAP

(Application S-88820, Permit S-55289)

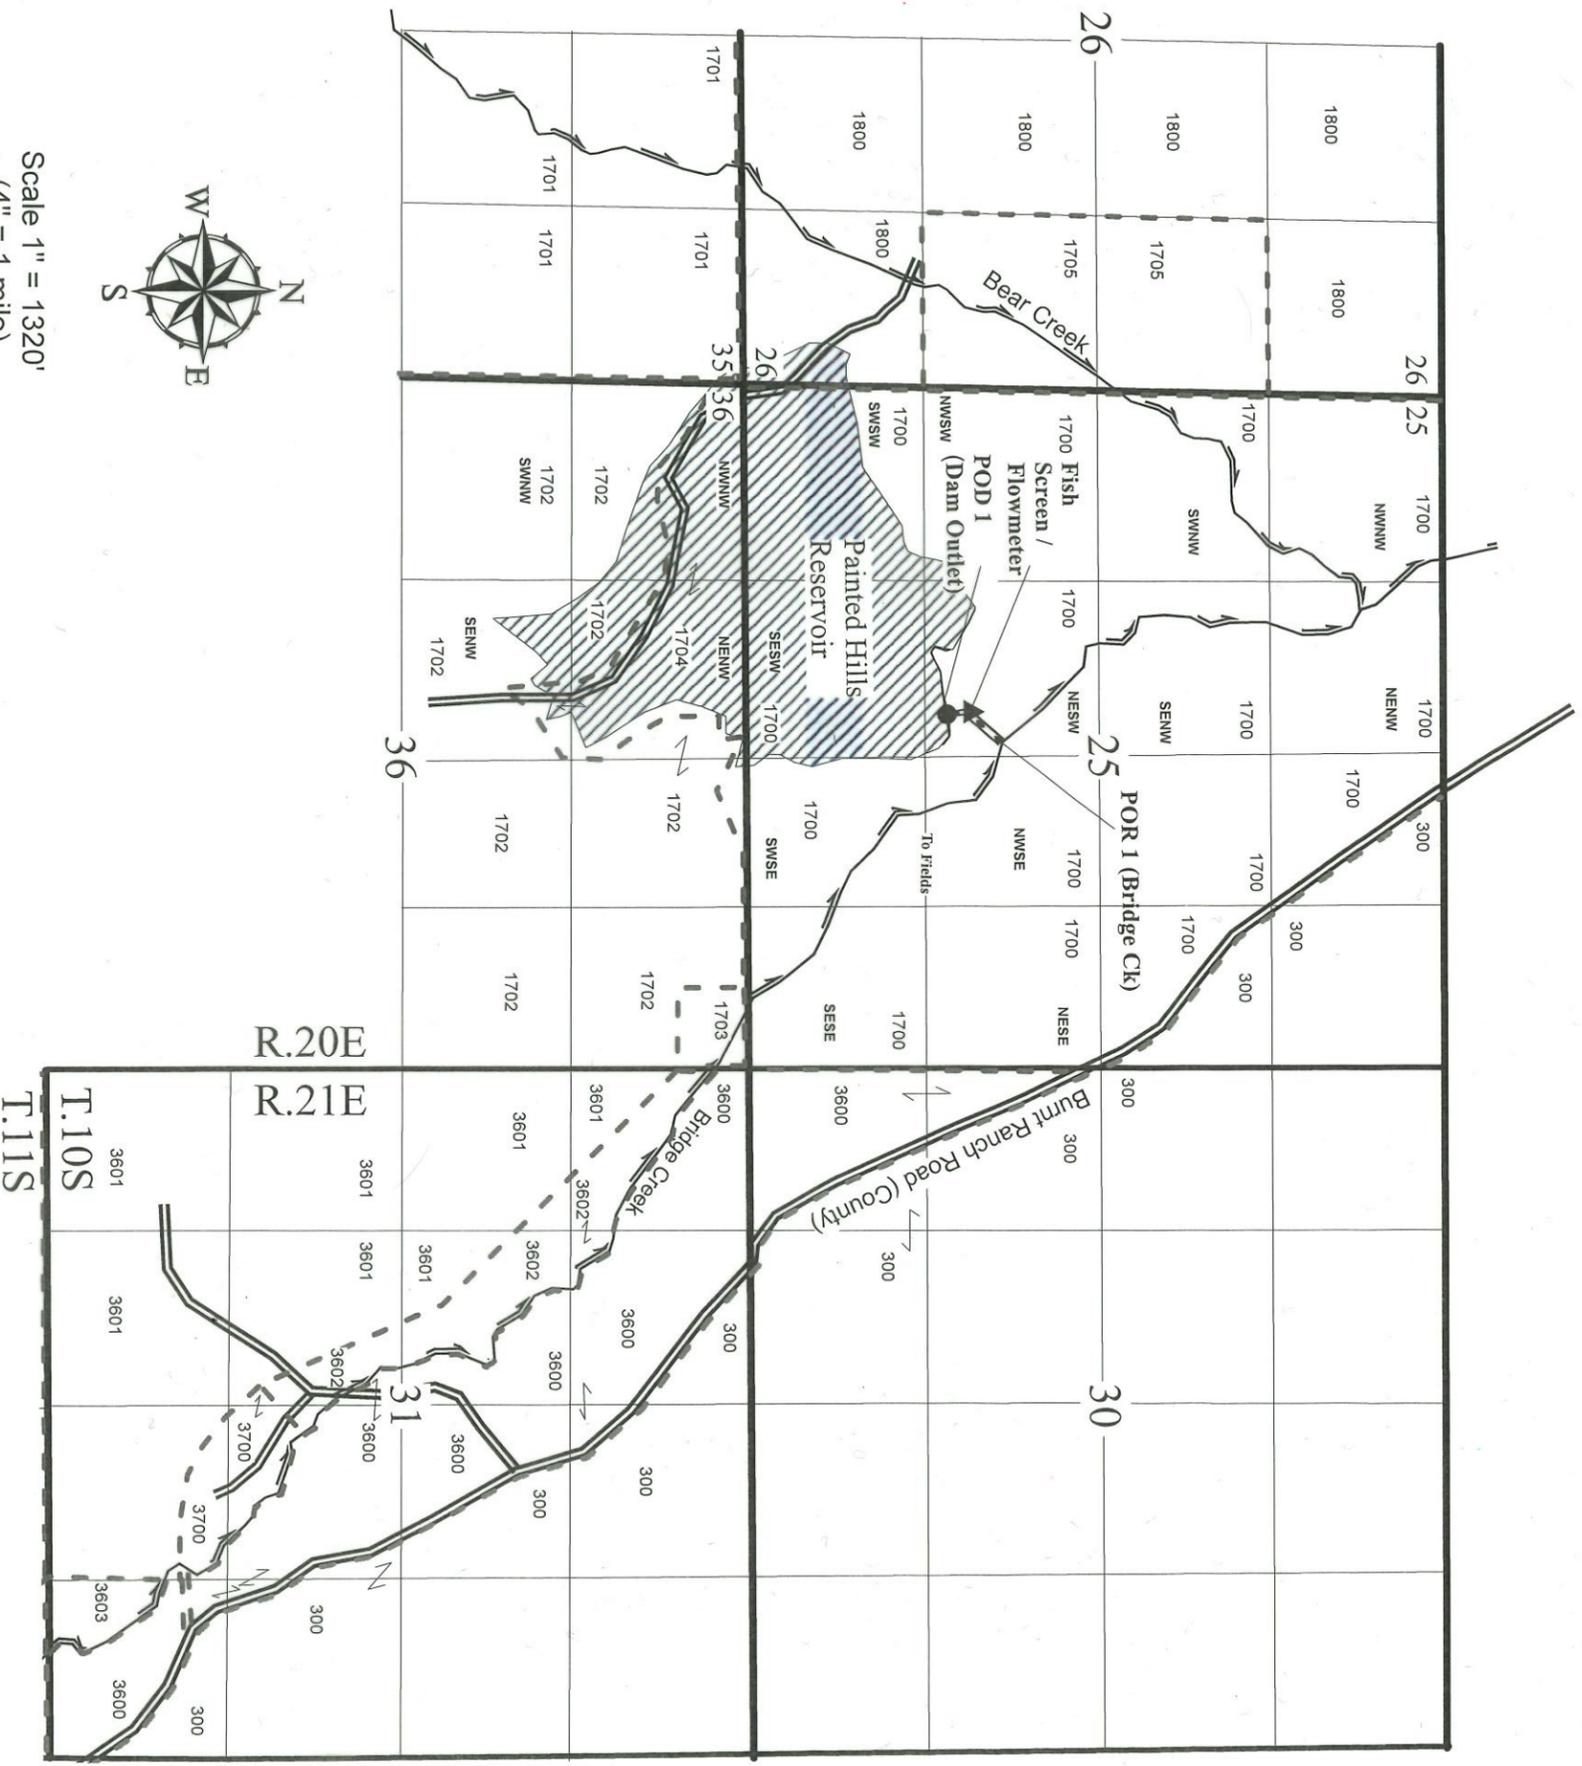

Locations (WGS84):
 POD 1 (Dam Outlet) 44.66888, -120.27536
 POR 1 (Bridge Ck) 44.67068, -120.27500

- Dam Outlet
- ▲ Fish Screen / Flowmeter
- ▬ Pipeline
- ▨ Painted Hills Reservoir
- - - Approximate Ownership Boundary (from taxlot maps)
- ▬ Road
- ▬ Creek

This map is for the purpose of locating a water right only and is not intended to provide legal dimensions or locations of property ownership lines.

CERTIFIED WATER RIGHT EXAMINER
 72665
Gabriel M. Williams
 GABRIEL M. WILLIAMS
 JULY 10, 2018
 STATE OF OREGON
 RENEWS: 6/30/24

FEB 03 2018
 OREGON

DRAWING: S-1.1	DRAWN BY: GMM	SHEET TITLE: COBU MAP	
PROJECT: COBU MAP S-55289		PROJECT LOCATION: MITCHELL, OREGON	
CLIENT: Bridge Creek Ranch, LLC			
DRAWING STATUS: DRAFT	DATE: 9/22/25	NO.:	DATE: