

# T.6S. R.4W. W.M.

POLK COUNTY, OREGON

One 5,000 GAL SPRING WATER BULGE TANK for IR & Domestic use, SW on Bethel Rd, Cert 95872

Insulated Pipe to Dwelling Site  
Closed Valve

Five 5,000 GAL IR BULGE TANKS

WELL, METER & BULGE TANKS DETAIL  
NTS


**NOTE:**

The preparer of the application map erroneously mistook the east line of the Harvey DLC for the N-S centerline of the section. There is no ownership, irrigation, or, system components in the NE 1/4 of Section 22.

TAX LOT  
6 4 22 201

 IRRIGATION

--- TAX LOT LINE

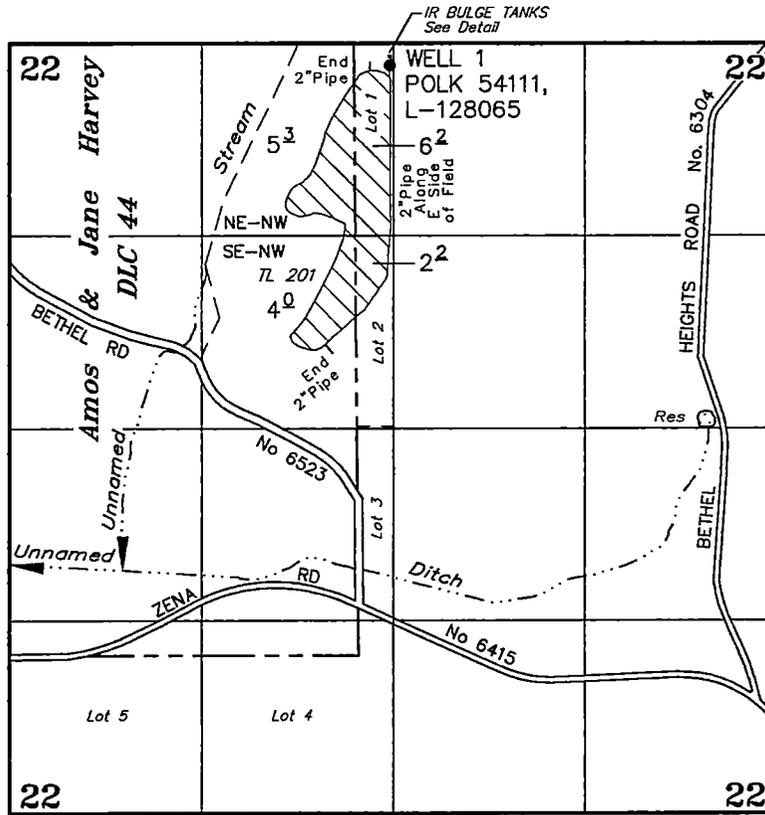

WELL 1: 152' SOUTH AND 27' WEST OF THE N 1/4-COR, SECTION 22  
METER: 106' SOUTH AND 26' WEST OF THE N 1/4-COR, SECTION 22

## CLAIM OF BENEFICIAL USE

UNDER

Application No. G-18808 Permit No. G-18400

**PEARLSTAD VINEYARD, LLC**

FEB 00 2026

October 22, 2025

SCALE: 1" = 1320'



NOTE: This map is for the purpose of identifying the location of water rights and has no intent to dimension or locate property ownership lines.

Renewal Date: 12-31-2027