


Claim of Beneficial Use - Webber

Application S-88401, Permit S-55089

Township 10S, Range 4W, W.M.

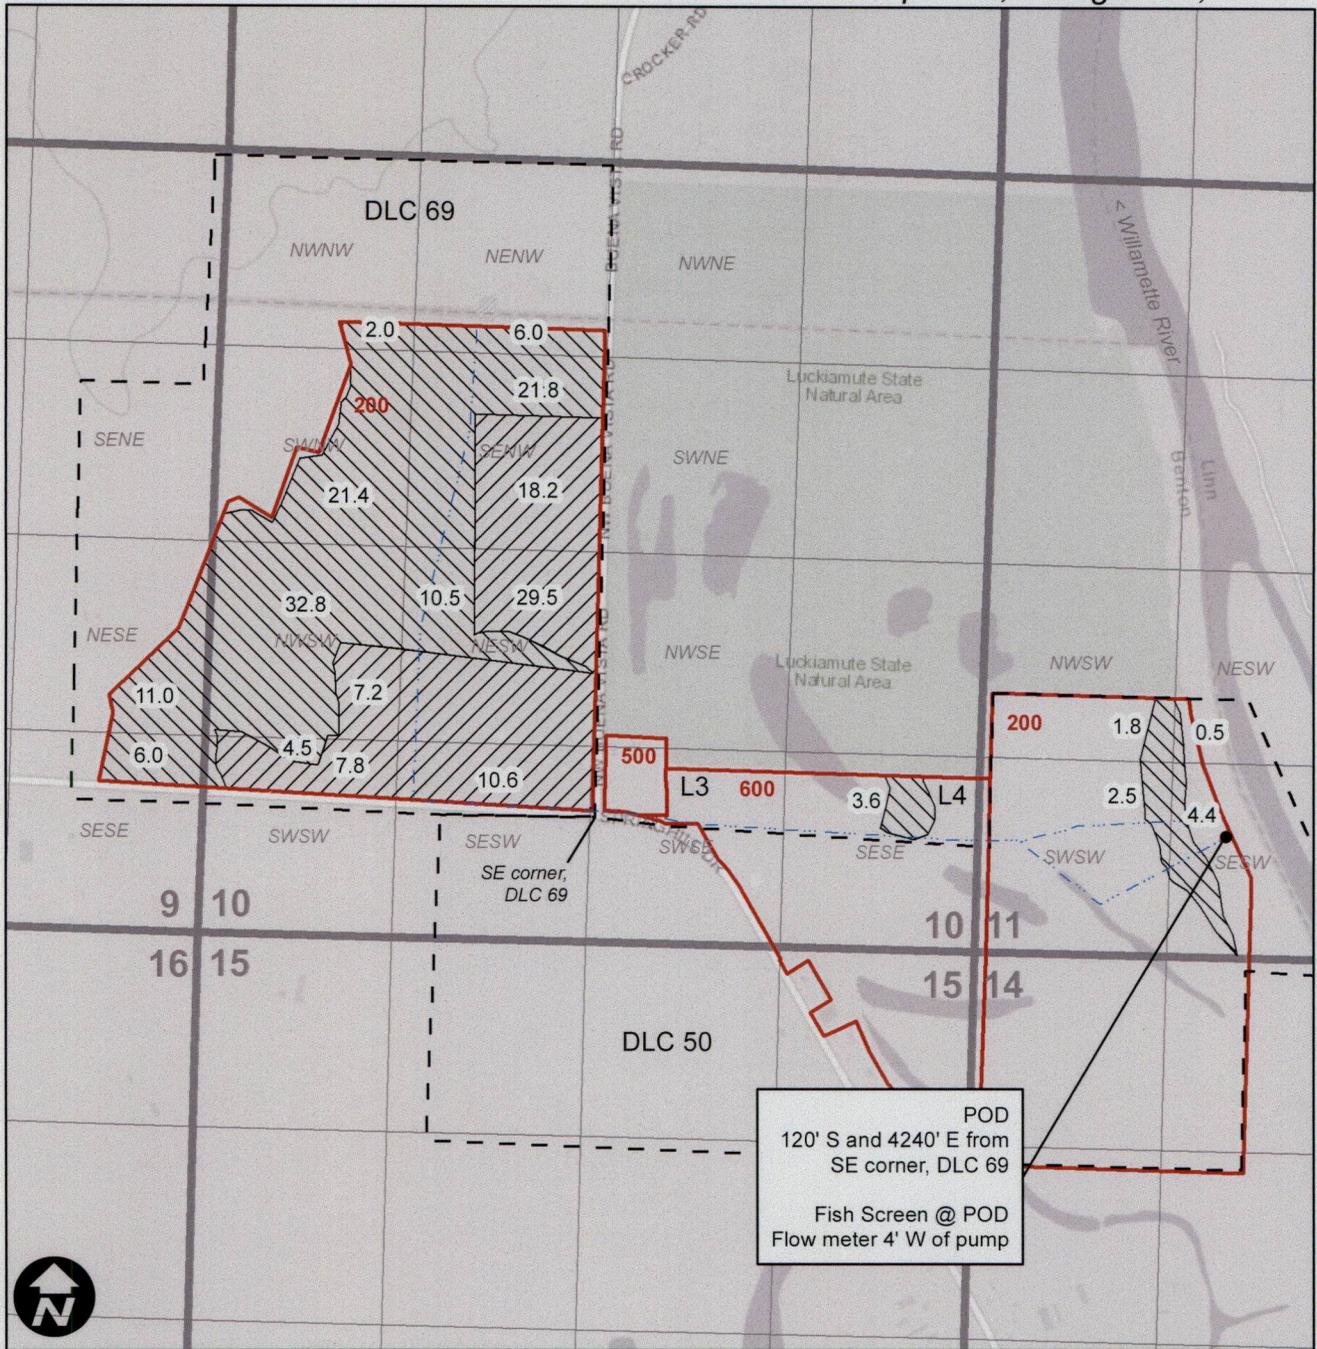

0 660 1,320 2,640 Feet This map is not intended to provide legal dimensions or locations of property ownership lines.

Legend

- POU IR
- Mainline
- DLC
- POU IS
- Taxlot

Received by OWRD

FEB 10 2026

Salem, OR



EXPIRES: 12-31-2026