


NW1/4SE1/4 of Section 17, Township 39 South, Range 8 West, W.M.
Josephine County, Oregon

APPLICATION: S-89101 PERMIT: S-55316

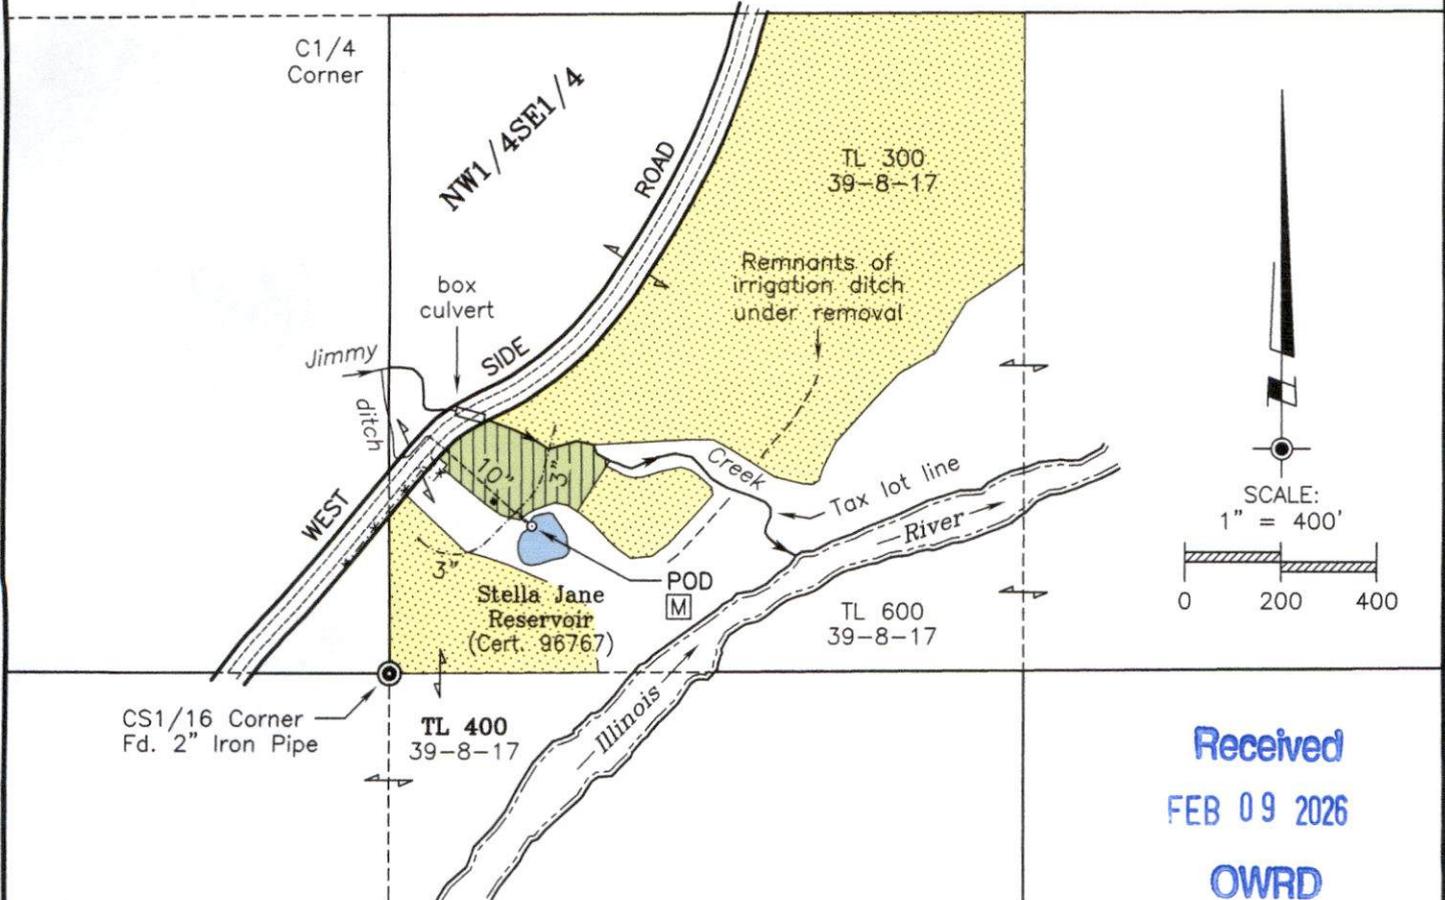

LEGEND:


-  Place of Use: 1.00 acres
-  Place of use per Certificates No. 98042 and CW-125 (17.05 ac.)
-  Existing 10" HDPE pipe (to reservoir)
-  Existing underground 3" PVC pipe
- POD Point of Diversion at 7.5hp sub. pump (Fish screen & meter attached to pump) 297' East & 304' North of the CS1/16 Corner
-  Flow meter at pump

Priority Date: April 14, 2021
 Usage: Fire Protection, Livestock, Wildlife (Jan. 1-Dec. 31)
 Irrigation (April 1-Oct. 31)
 A 10 page Site Report accompanies this plat.

This map is not intended to provide legal dimensions or locations of property ownership lines.

darby.dwg

PROJECT NO. 1457-25-888
DRAWING NO. 240-8.5.11
DATE: Nov. 13, 2025
SCALE: 1" = 400'
SHEET NO. 1 of 1

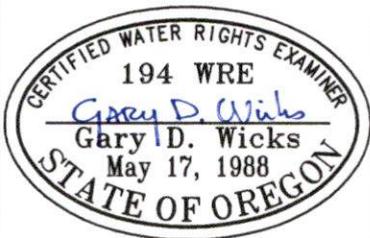

RENEWAL DATE: 6-30-26

PLAT FOR CLAIM OF BENEFICIAL USE

LOCATED IN:
 NW1/4SE1/4 of Section 17,
 Township 39 South, Range 8 West, W.M.
 Josephine County, Oregon

PREPARED FOR:
 James B. Darby
 6789 North Applegate Road
 Grants Pass, OR 97527
 Tel: 907-229-0629

PREPARED BY:
 WICKS ENGINEERING & SURVEYING
 311 N.E. "D" Street
 Grants Pass, OR 97526
 Tel: 541-479-3436