


Township 33S, Range 1E.

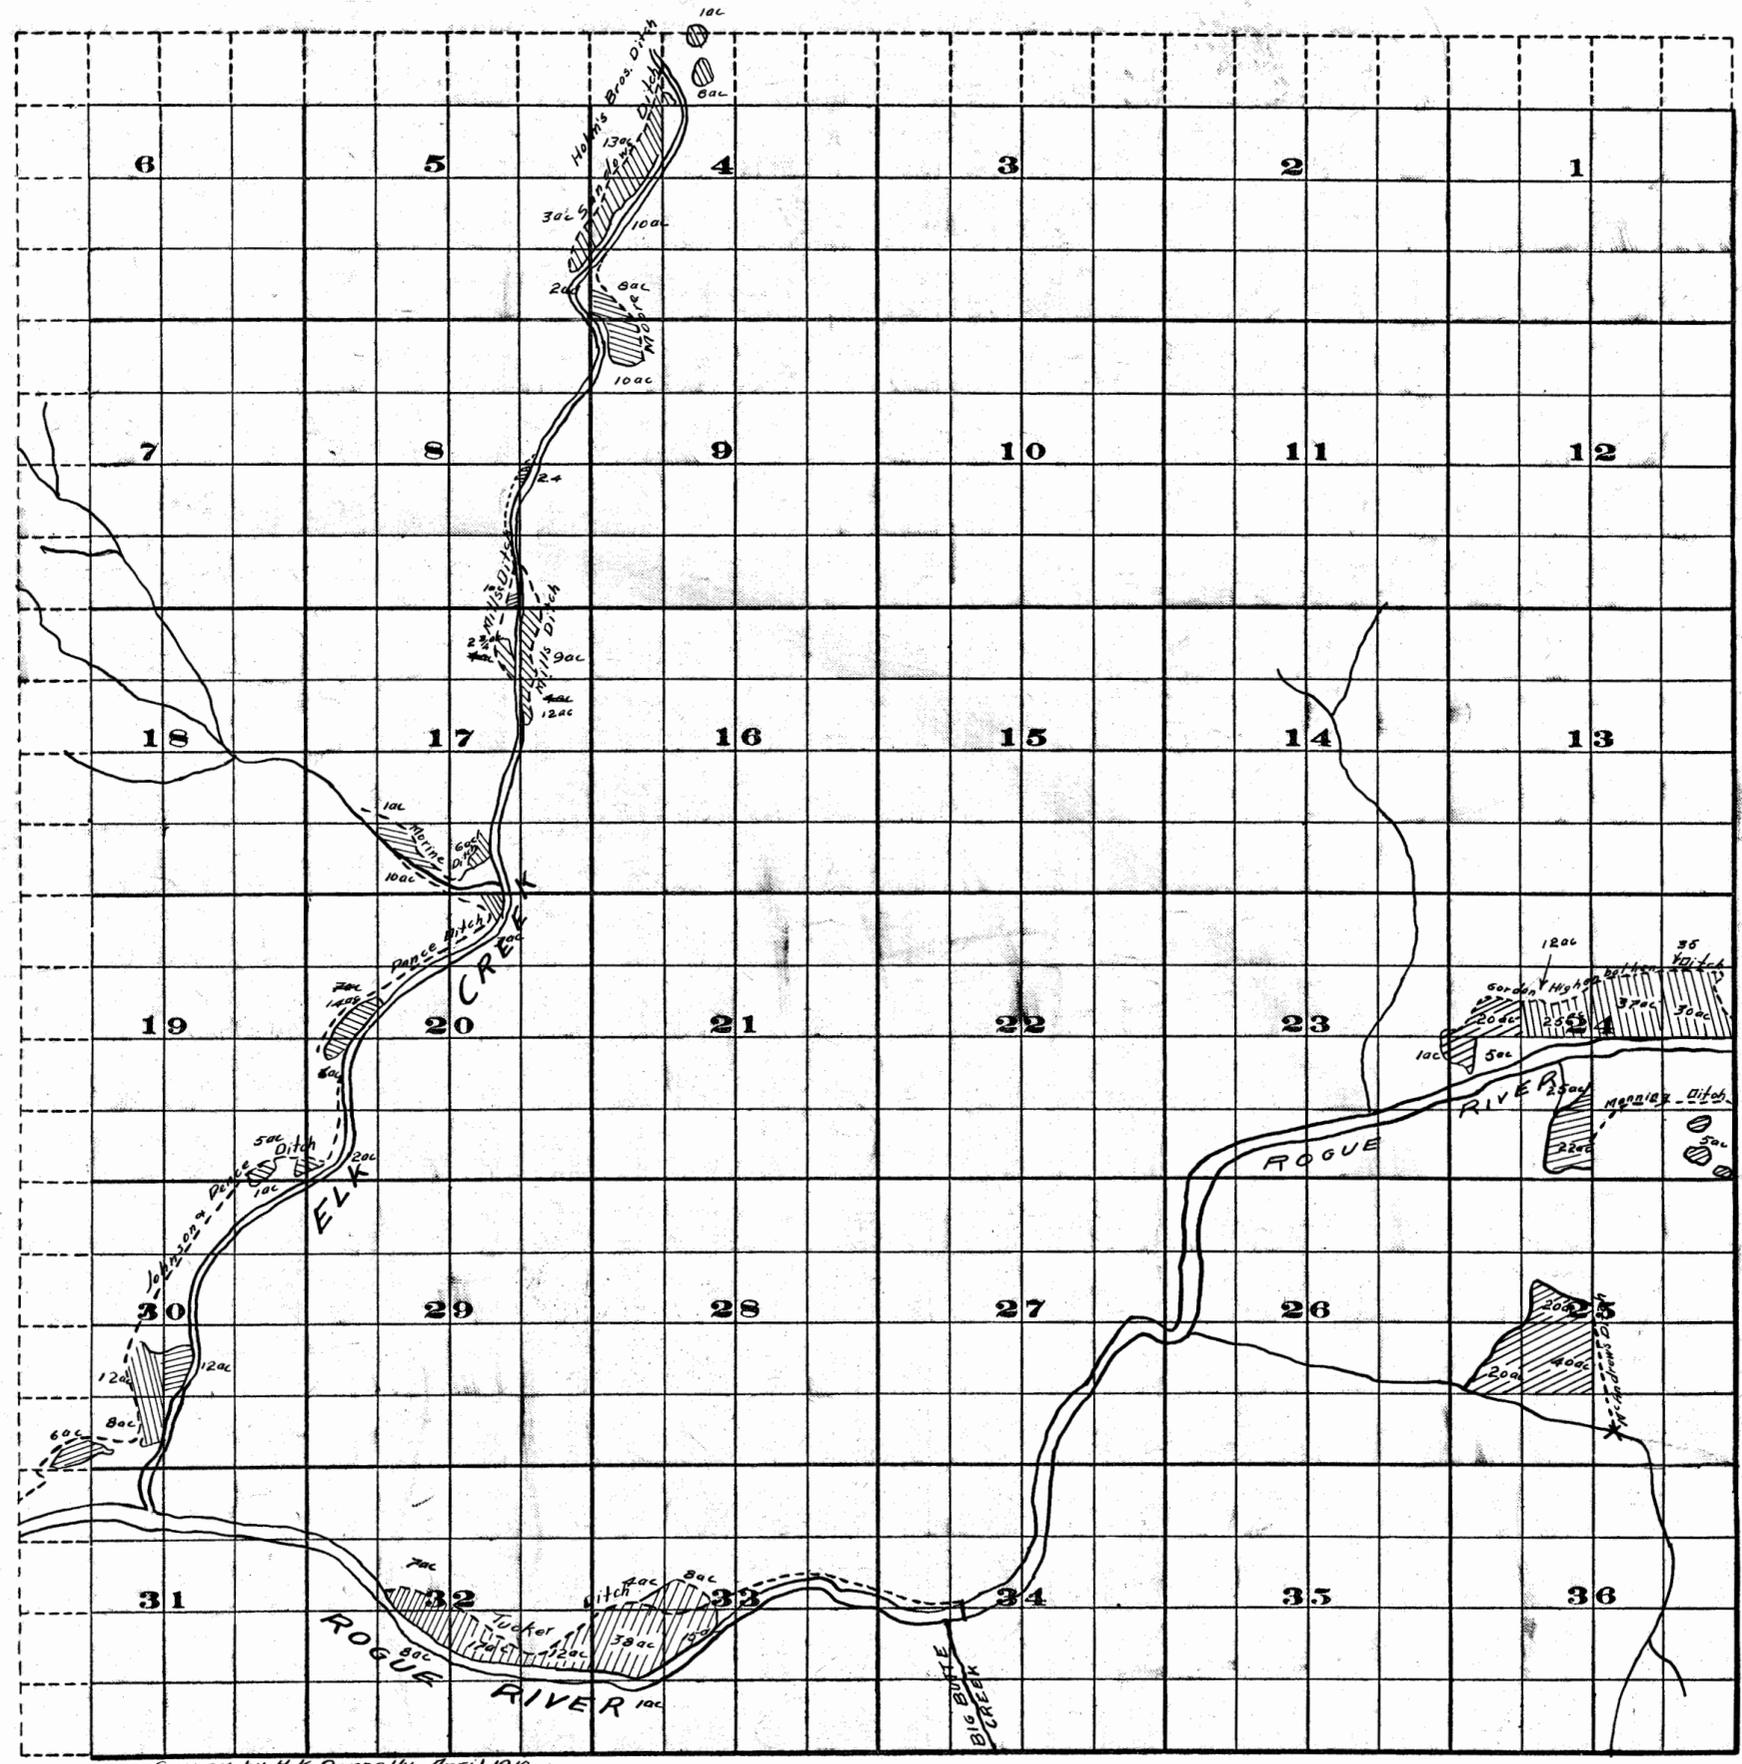

Survey by H.K. Donnelly April 1910

FROM OFFICE OF THE STATE ENGINEER, SALEM, OREGON

M.D.
D.F.M. 117-11

Scale of Feet.

Adjudication

Rogue River and Tributaries

John H Lewis State Engr

Examined Sept 18, 1911