



OWNERS:
 FOLEY FAMILY FARMS LP
 1707 VILLAGE CENTER CIRCLE
 LAS VEGAS, OR 89134

CLAIM OF BENEFICIAL USE MAP

T7S, R5W, SECT. 4, TAX LOT 203, W.M.
 T7S, R5W, SECT. 3, TAX LOT 400 & 500
 T7S, R5W, SECT. 10, TAX LOT 501 & 502
 POLK COUNTY


 PRIMARY IRRIGATION
 APP S-88827
 PERMIT S-55297
 69.1 ACRES

- LEGEND**
-  SECTION LINE
 -  1/4 1/4 LINE
 -  DLC LINE
 -  TAX LOT LINE
 -  POD
 -  SECTION CORNER
 -  DLC CORNER
 -  4" DIA. PVC BURIED IRR. MAIN
 -  UNNAMED STREAM

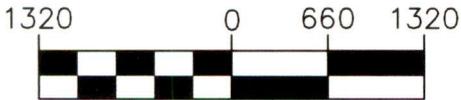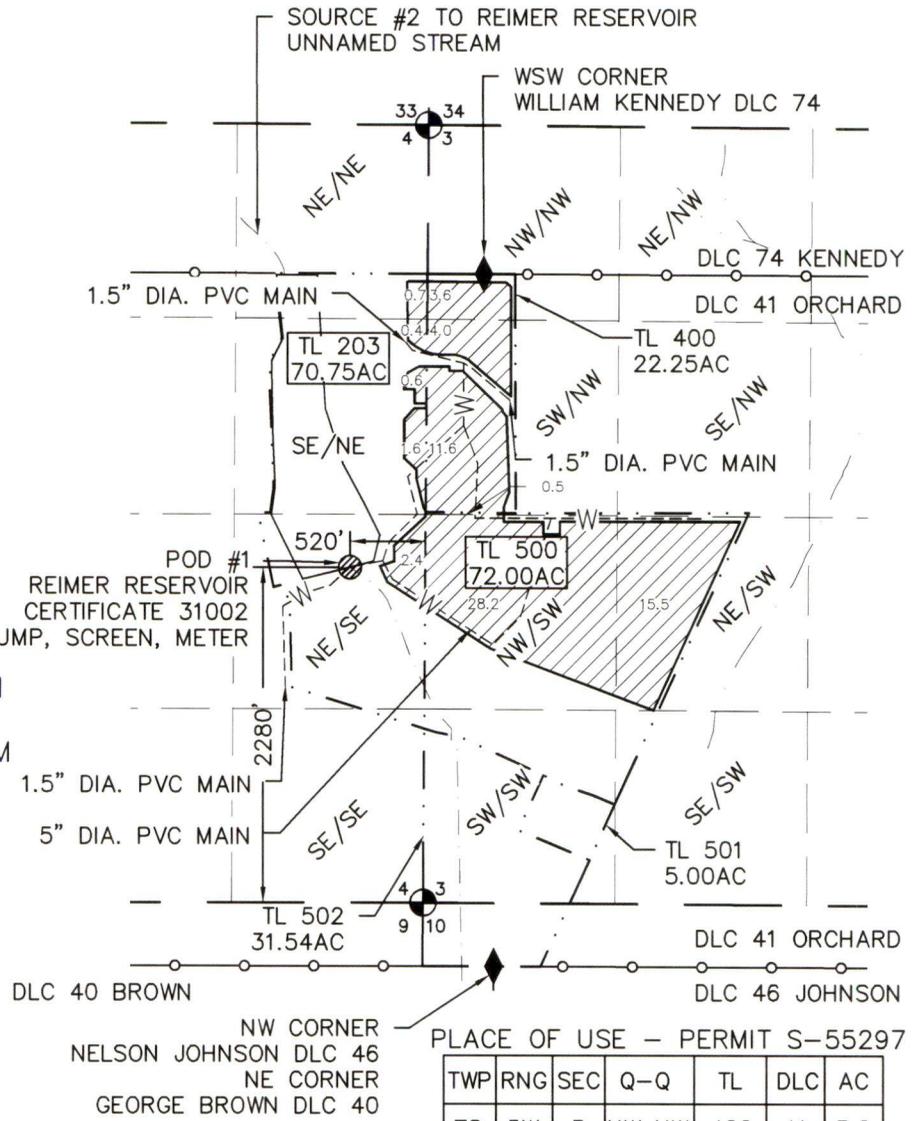

1 inch = 1320ft.
 PRINT SCALE=8.5"x11"

Received
 FEB 12 2026
 OWRD

PLACE OF USE - PERMIT S-55297

TWP	RNG	SEC	Q-Q	TL	DLC	AC
7S	5W	3	NW NW	400	41	3.6
7S	5W	3	SW NW	400	41	15.6
7S	5W	3	NE SW	500	41	15.5
7S	5W	3	NW SW	500	41	28.2
7S	5W	3	SW NW	500	41	0.5
7S	5W	4	NE NE	203	41	0.7
7S	5W	4	SE NE	203	41	2.6
7S	5W	4	NE SE	203	41	2.4

TOTAL ACRES 69.1

POD	TWP	RNG	SEC	Q-Q	TL	DLC	MEASURED DISTANCE
#1-REIMER RESERVOIR	7S	5W	4	NE SE	203	41	2280'N AND 520'W FROM SE CORNER OF SECTION 4

BLUNDON
ENGINEERING, LLC

NOTE: THIS MAP IS PRODUCED TO APPLY FOR THE BENEFICIAL USE OF A WATER RIGHT. IT IS NOT INTENDED TO PROVIDE INFORMATION RELATIVE TO THE LOCATION OF PROPERTY LINES.

PO BOX 786
 HILLSBORO, OREGON 97123
 541-510-5910
 NICK@BLUNDONENGINEERING.COM

Certified Water Right Examiner
 #83725
Nicholas G. Blundon
 NICHOLAS GORDON BLUNDON
 MAY 14, 2019
 STATE OF OREGON
 EXPIRES 12/31/2027