


Claim of Beneficial Use

S1 & S12, T11S, R1W, & S7, T11S, R1E, Linn County

T-13911



1 IN = 1320 FT
0 660 1320

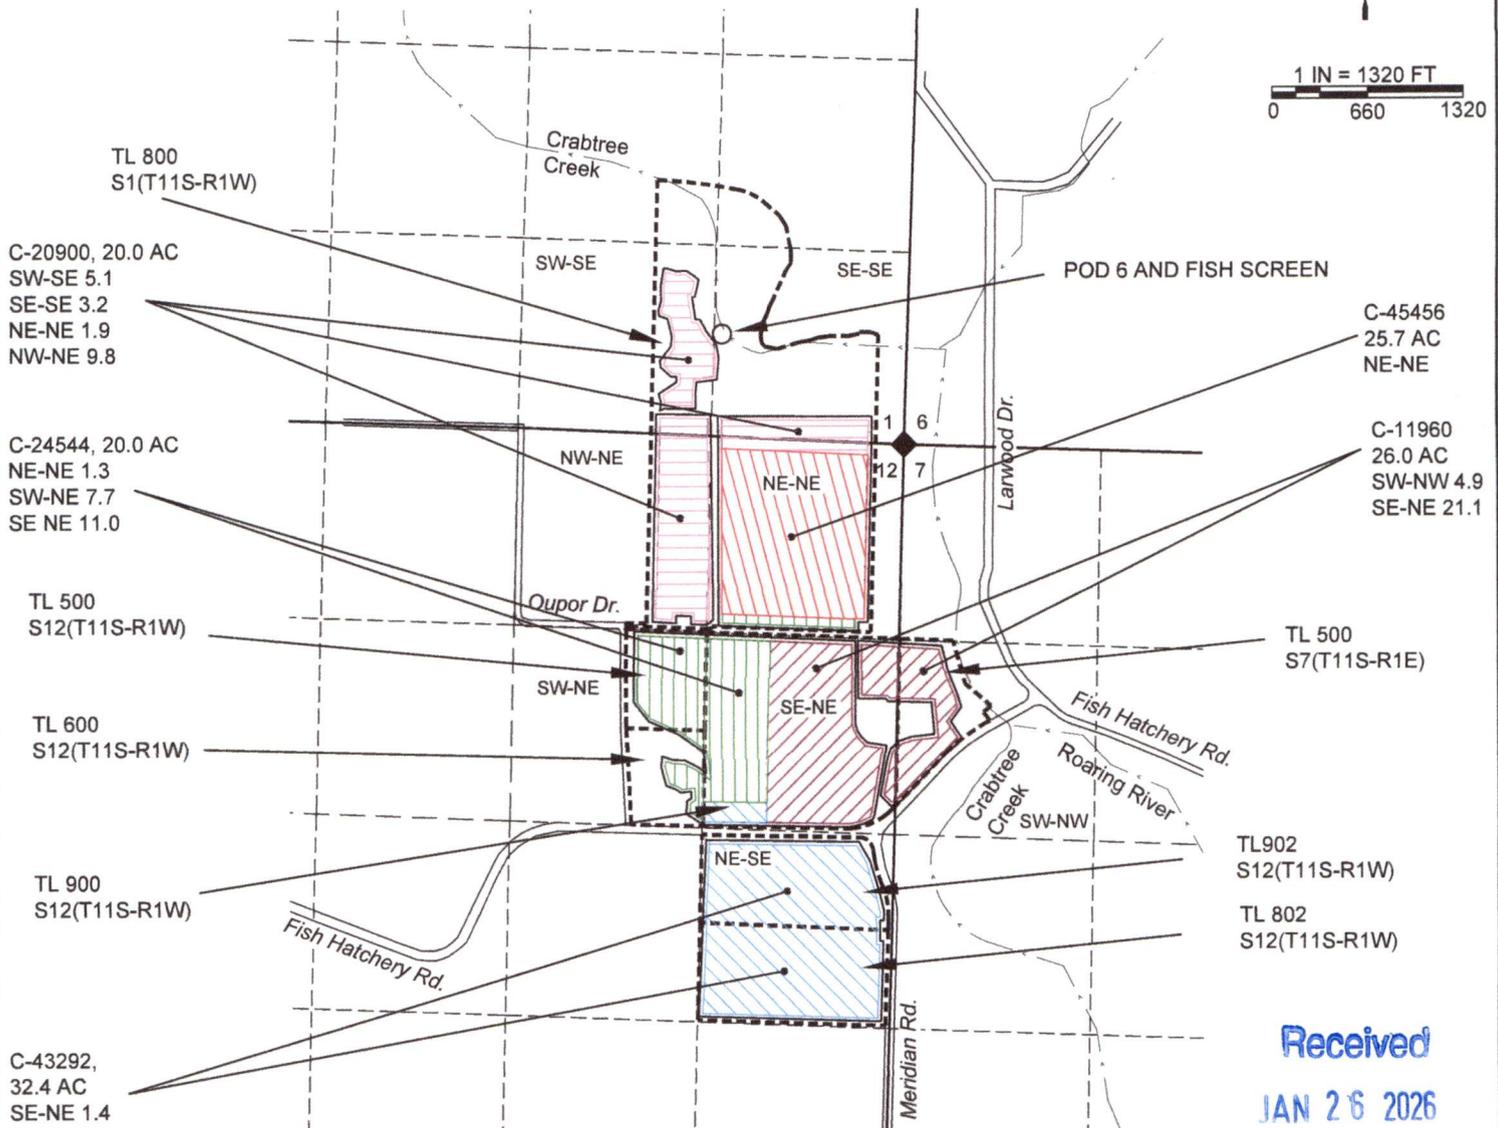

LOCATION of ADDITIONAL Point of Diversion (POD)
POD 6 640' N & 105' E of S1/4 of S1

Received
JAN 26 2026

Received
FEB 17 2026

OWRD

- NOTES:
- THIS MAP IS NOT INTENDED TO PROVIDE LEGAL DIMENSIONS OR LOCATIONS OF PROPERTY OWNERSHIP LINES.
 - PROPERTY LINES AND QUARTER-QUARTER LINES ARE BASED ON THE TAX ASSESSOR MAPS IN THE AREA.
 - WATER CONVEYANCE LINES SHALL BE ALL WITHIN THE PROPERTY AND THEREFORE ARE NOT SHOWN.
 - THE RRIGATION AND POD LOCATIONS ARE BASED ON JUL 2024 GOOGLE AERIAL PHOTO.



Exp. 30 JUN 2026

- LEGEND**
- DONATION LAND CLAIM (DLC) CORNER (NONE IN AREA)
 - SECTION CORNER
 - POINT OF DIVERSION (POD)
 - STREAM OR SURFACE DRAINAGE
 - TAX LOT LINE
 - SECTION LINE
 - QUARTER-QUARTER LINE
 - DLC LINES (NONE)
 - CONVEYANCE LINES (NOT SHOWN, ALL ON PROPERTY)

MAP BY:
ASPEN RURAL LAND CONSULTING
ERIC URSTADT, PE, PLS
971-250-1520
DEC 2021
WVL-FISHHATCHERY4E