



Oregon Water Resources Department
 725 Summer Street NE Suite A
 Salem, Oregon 97301
 (503) 986-0900
 www.oregon.gov/OWRD



Ownership Update for Certificated Rights Only

NO FEES ARE REQUIRED TO SUBMIT THIS FORM

NOTICE: A certificate of water right typically stays with the land. To track water right ownership, the Department requests that this form be submitted to the Department. **To update multiple rights, a separate form is required for each right.** If you have any questions about this form, please contact your local watermaster, or call the Water Resources Department at (503) 986-0900.

Note: Use the [assignment](#) form to change ownership on pending applications, permits, transfers, groundwater registrations, or limited licenses.

Current Landowner Information				
Name:				
Mailing Address:				
City:		State:		Zip:
Phone:		Email:		

Property Information				
County:		Township:		Range:
Tax Lot #:				
Street Address of Water Right:				

Water Right Information				
Application:				
Permit:				
Certificate:				
Are all the lands associated with this water right owned by the requestor?		Yes		No
(If no, include a map showing the portion of the water right involved) 3.8 acs (TL 1500) and 11.6 acs (TL 1100)				


Signature and Date		
Name of individual completing form:		
Phone or email:		Date:
Signature of requestor:	<i>Richard Parsons</i>	

The Department does not change names on water right certificates. This form will be placed in the file for future reference only. If mailed, the Department will not provide acknowledgment of receipt.

This form can be mailed to the address above or sent by email to wrd_dl_customerservice@water.oregon.gov

FINAL PROOF MAP UNDER T-8029

E-RECEIVED
2/20/2026
OWRD

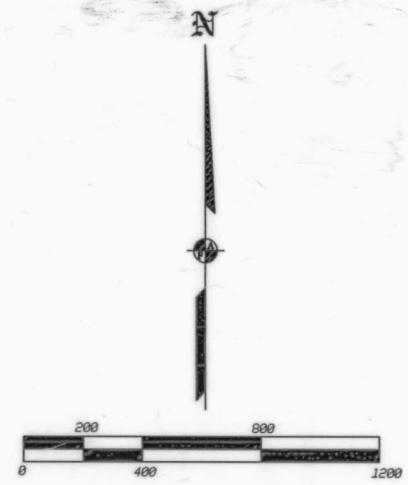

TIES FROM NE COR SEC. 2 TO DIV. PTS.

DIV. PT. #1	1269' W & 548' S
DIV. PT. #2	1326' W & 404' S
DIV. PT. #3	2227' W & 479' S
FORMER DIV. PT.	1829' E & 2285' S

LEGEND

IRRIGATED AREA

	JAMES, RAY L.	17.0 ACRES TOTAL
	FINCHER, CLAYTON	13.3 ACRES TOTAL
	BROWN, LOREN	6.1 ACRES TOTAL
	HARLEY E. STEVENSON	15.4 ACRES TOTAL
	HOOPER, PAUL G.	10.3 ACRES TOTAL

IRRIGATED AREA

	JAMES, DOUGLAS S.	1.0 ACRE TOTAL
	SALKIN, HELENA Z. TRUSTEE	7.9 ACRES TOTAL

TRANSFERED DIVERSION POINTS

- DIV. PT. #1 = SALKIN
- DIV. PT. #2 = R. JAMES, D. JAMES, BROWN, FINCHER & STEVENSON
- DIV. PT. #3 = HOOPER


□ INDICATES DWELLING

THE PREPARATION OF THIS MAP IS TO IDENTIFY THE WATER RIGHT ONLY AND IS NOT INTENDED TO PROVIDE LEGAL DIMENSIONS OF PROPERTY OWNERSHIP LINES.

RECEIVED

OCT 27 2000

WATER RESOURCES DEPT.
SALEM, OREGON

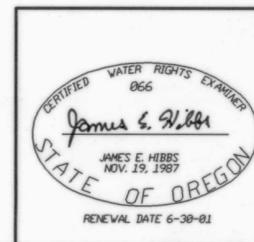

TITLE: FINAL PROOF MAP
FOR: RAY JAMES, CLAYTON FINCHER, LOREN BROWN, HARLEY STEVENSON, PAUL HOOPER, HELENA SALKIN & DOUGLAS JAMES
APPLICANT: ILLINOIS VALLEY S.W.C.D.
P.O. BOX 352
CAVE JUNCTION, OR 97523
(541) 592-3731

L.J. FRIAR & ASSOCIATES P.C.
CONSULTING LAND SURVEYORS
516 W. 8TH ST., MEDFORD, OR.
(541) 772-2782

DATE:	25 SEP 2000
SCALE:	1 inch = 400 feet
DRAWN BY:	JEH/NEH
CHK BY:	
ORIGIN:	
ROTATION:	0°
JOB#:	98143FP
Sheet	1 of 1

COBU MAP # 0084

0084