

LOCATED IN SECTION 33 & 32
 T4S R12E W.M.
 &
 LOCATED IN SECTION 04 & 05
 T5S R12E W.M.
 WASCO COUNTY, OREGON

CLAIM OF BENEFICIAL USE MAP

TAX LOT 5200
 TAX MAP 04S12E
 &
 TAX LOT 900
 TAX MAP 05S12E

APPLICATION S-84767
 PERMIT S-54669

CWRE STATEMENT

THIS MAP IS NOT INTENDED TO PROVIDE LEGAL DIMENSIONS OF LOCATIONS OF PROPERTY OWNERSHIP LINES.

MAP INFORMATION

COORDINATE SYSTEM: STATE PLANE OREGON NORTH ZONE 3601
 DATUM: NORTH AMERICAN DATUM OF 1983

DATA SOURCES

TAX LOT AND ROAD: WASCO COUNTY GIS
 SECTION LINEWORK: WASCO COUNTY GIS

PREPARED FOR


BLAINE LIMITED PARTNERSHIP/RICHARD BLAINE
 PO BOX 450
 PARKDALE, OR 97041

Received
 FEB 20 2026
 OWRD




DATE: 12/05/2025

CLAIM OF BENEFICIAL USE MAP		EXHIBIT
BLAINE LIMITED PARTNERSHIP WATER RIGHTS		A
AKS ENGINEERING & FORESTRY, LLC 12965 SW HERMAN RD, STE 100 TUALATIN, OR 97062 503.563.6151 WWW.AKS-ENG.COM		DRWN: BGZ CHKD: SRR AKS JOB: 11833

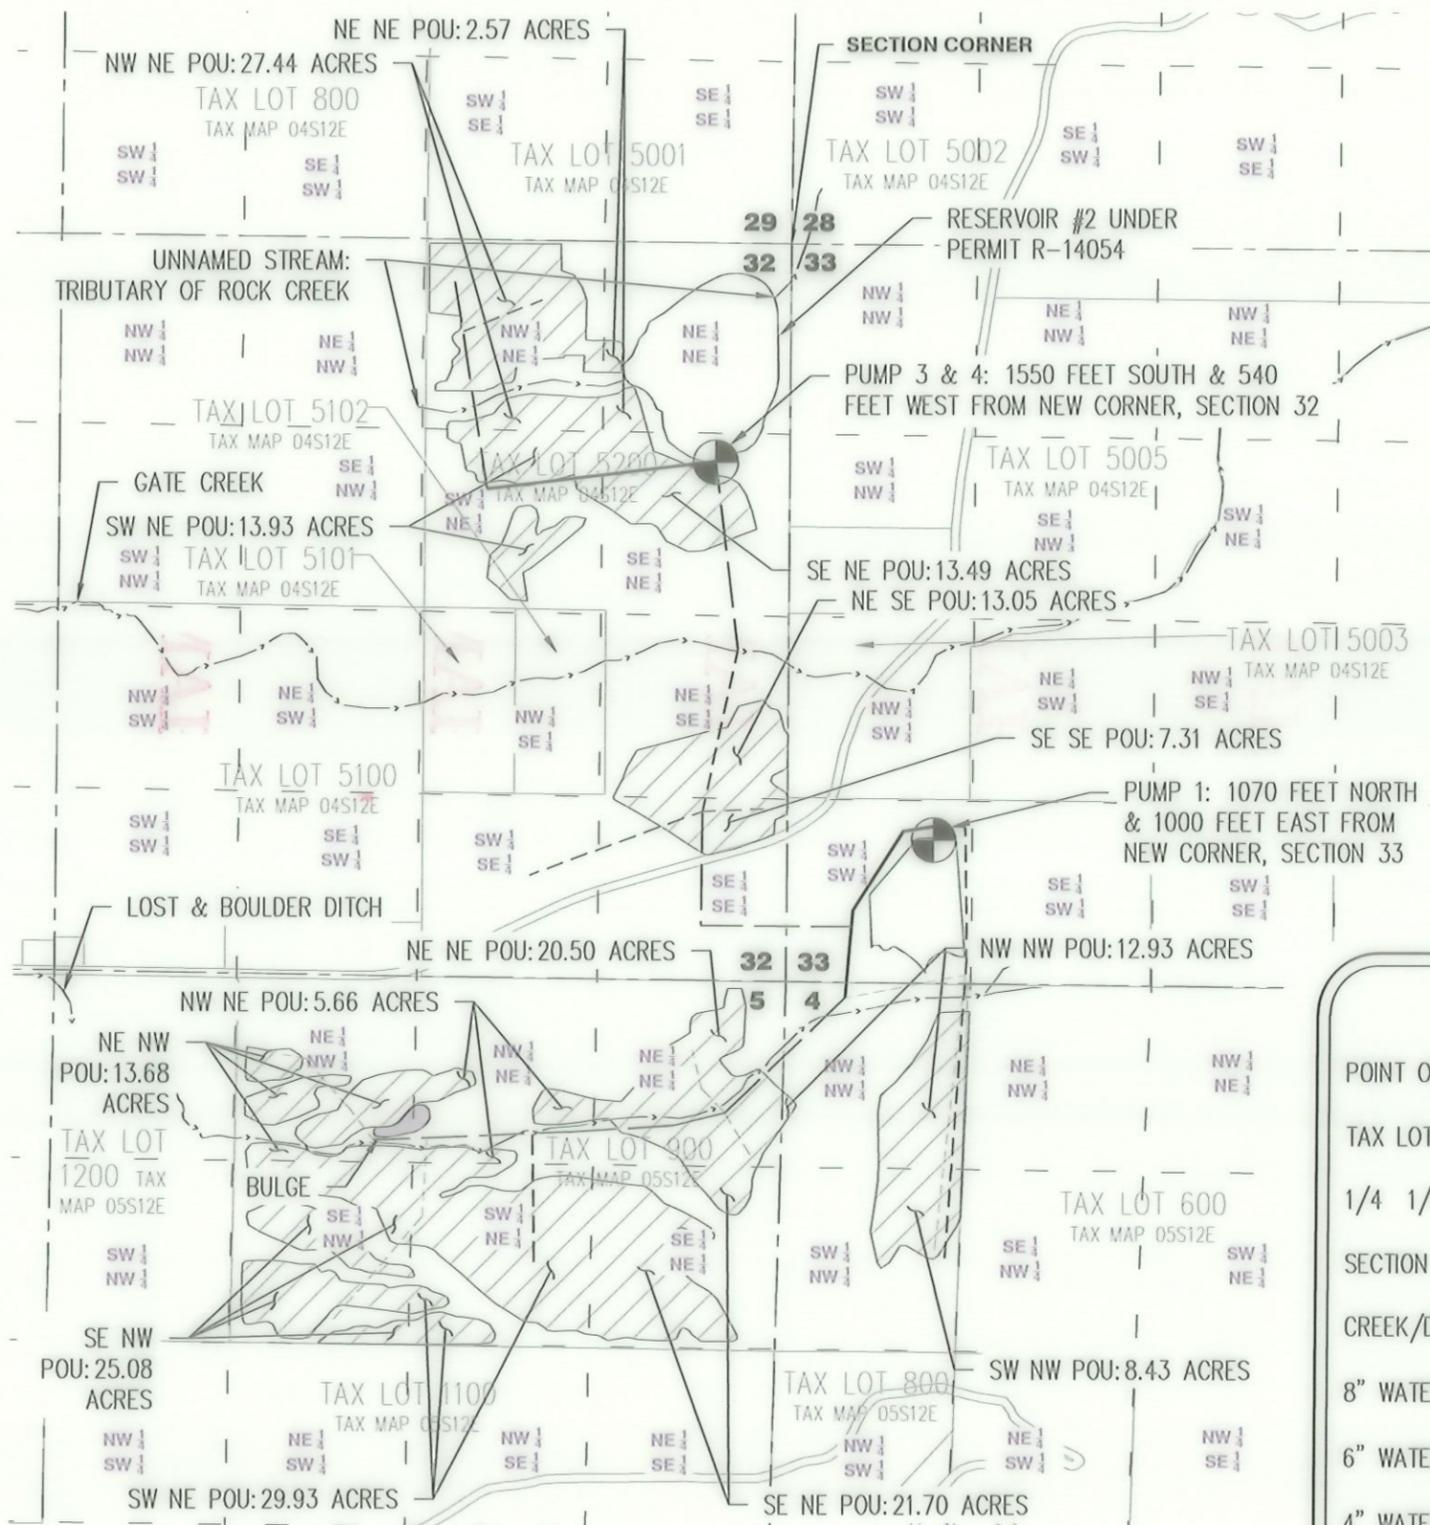

LEGEND

- POINT OF APPROPRIATION (POA)
- TAX LOT BOUNDARY
- 1/4 1/4 SECTION LINE
- SECTION LINE
- CREEK/DITCH CENTERLINE
- 8" WATER CONVEYANCE LINE
- 6" WATER CONVEYANCE LINE
- 4" WATER CONVEYANCE LINE
- 2"-3" WATER CONVEYANCE LINE
- PLACE OF USE; SUPPLEMENTAL IRRIGATION TOTAL OF 215.70 ACRES

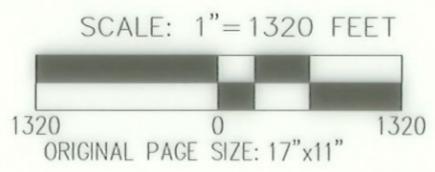

COBU MAP # 2170

DWG: 11833 COBU_S54669 | LAYOUT1