

LOCATED IN SECTION 32
 T4S R12E W.M.
 WASCO COUNTY, OREGON

CLAIM OF BENEFICIAL USE MAP

TAX LOT 5200
 TAX MAP 04S12E

APPLICATION R-81465
 PERMIT R-14054

CWRE STATEMENT

THIS MAP IS NOT INTENDED TO PROVIDE LEGAL DIMENSIONS OF LOCATIONS OF PROPERTY OWNERSHIP LINES.

MAP INFORMATION


COORDINATE SYSTEM: STATE PLANE OREGON NORTH ZONE 3601
 DATUM: NORTH AMERICAN DATUM OF 1983

DATA SOURCES

TAX LOT AND ROAD: WASCO COUNTY GIS
 SECTION LINEWORK: WASCO COUNTY GIS



PREPARED FOR

BLAINE LIMITED PARTNERSHIP/RICHARD BLAINE
 PO BOX 450
 PARKDALE, OR 97041

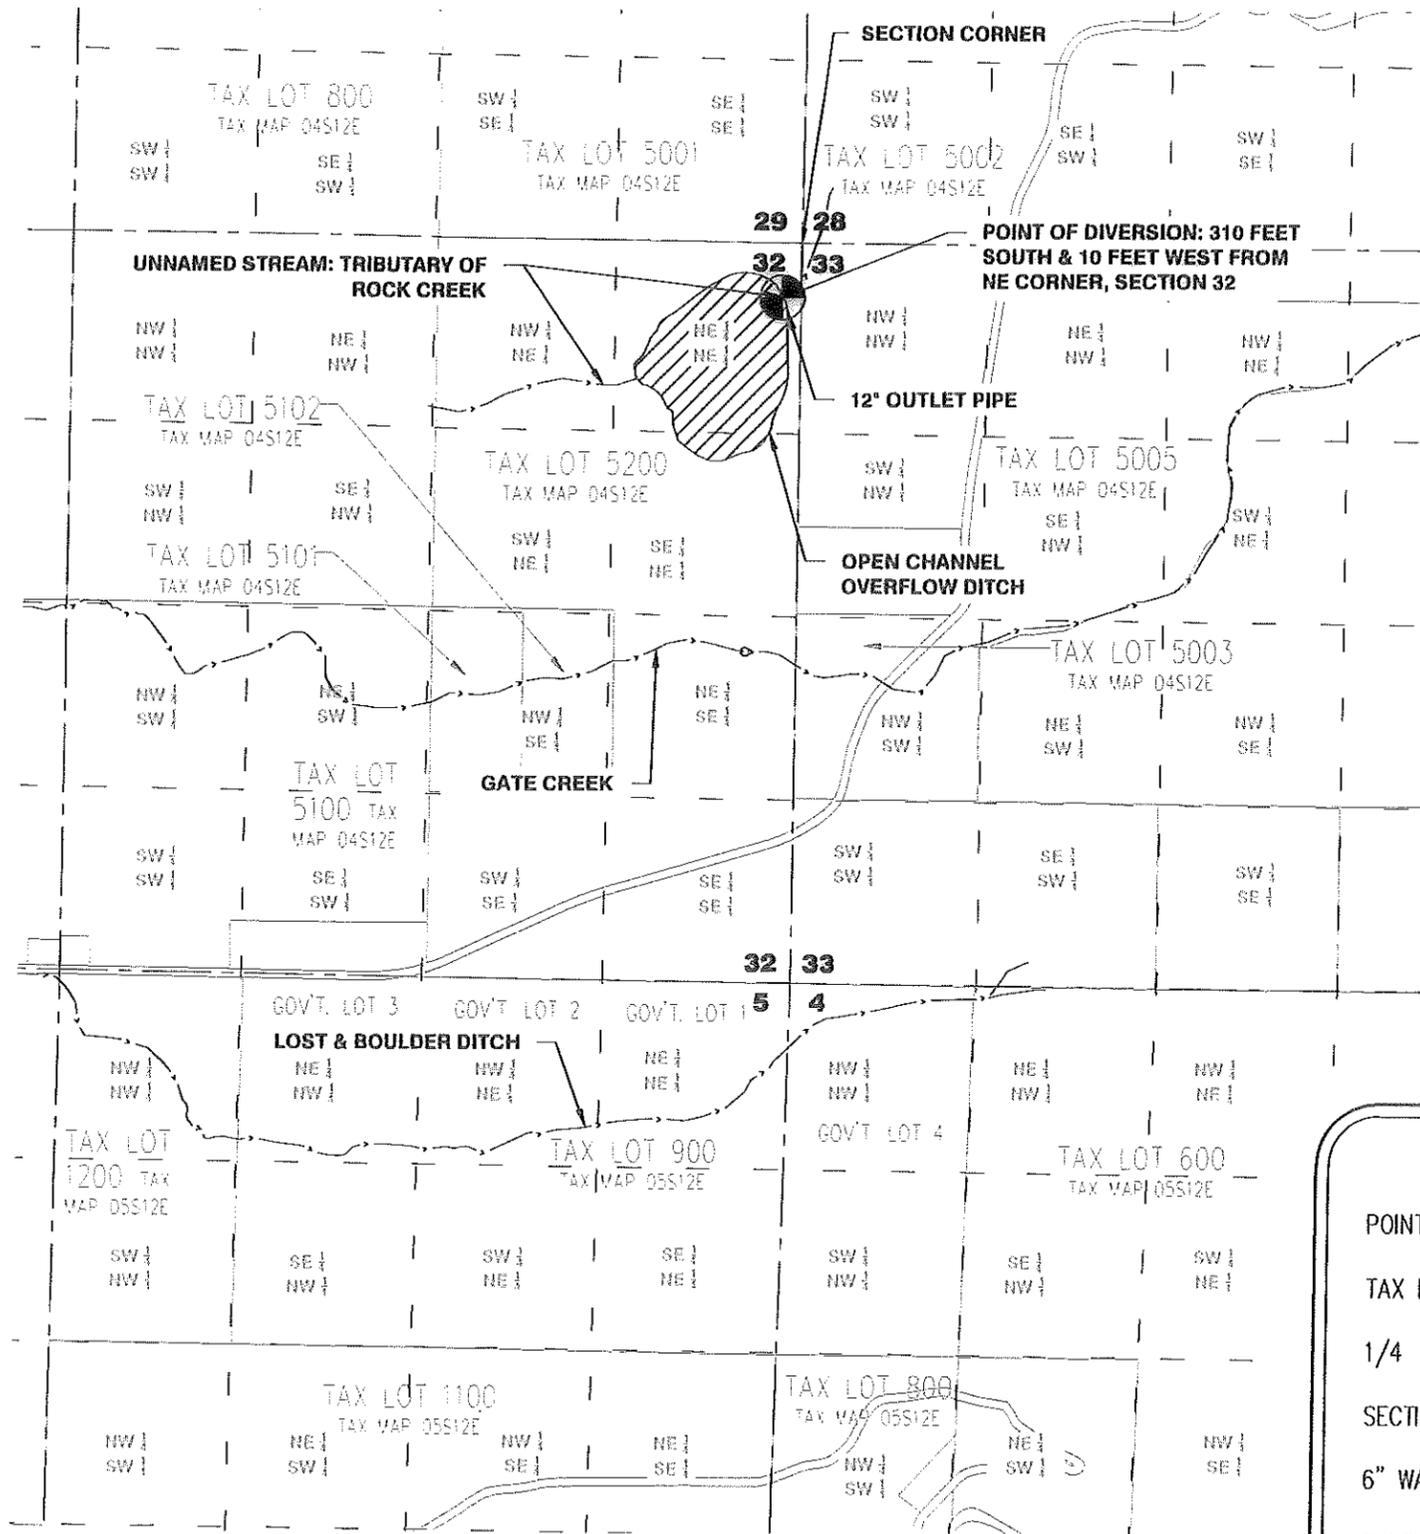


LEGEND

- POINT OF DIVERSION (POD)
- TAX LOT BOUNDARY
- 1/4 1/4 SECTION LINE
- SECTION LINE
- 6" WATER CONVEYANCE LINE
- CREEK/DITCH CENTERLINE
- RESERVOIR #2: 258 ACRE-FEET

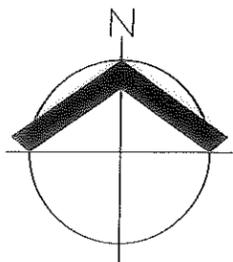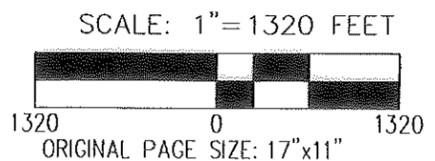

Received
 FEB 21 2026
 CWRD

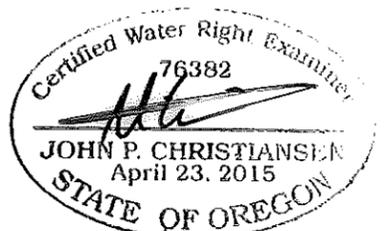

DATE: 02/10/2026

CLAIM OF BENEFICIAL USE MAP		EXHIBIT
BLAINE LIMITED PARTNERSHIP WATER RIGHTS		A
AKS ENGINEERING & FORESTRY, LLC 12965 SW HERMAN RD, STE 100 TUALATIN, OR 97062 503.563.6151 WWW.AKS-ENG.COM		DRWN: BGZ CHKD: SRR AKS JOB: 11833



DWG: 11833 COBU_R14054 | LAYOUT