

LOCATED IN SECTION 4, 5, 32, & 33
 T4S R12E W.M.
 WASCO COUNTY, OREGON

CLAIM OF BENEFICIAL USE MAP

TAX LOT 900 & 5200 APPLICATION R-84768
 TAX MAP 04S12E PERMIT R-14868

CWRE STATEMENT
 THIS MAP IS NOT INTENDED TO PROVIDE LEGAL DIMENSIONS OF LOCATIONS OF PROPERTY OWNERSHIP LINES.

MAP INFORMATION
 COORDINATE SYSTEM: STATE PLANE OREGON NORTH ZONE 3601
 DATUM: NORTH AMERICAN DATUM OF 1983

DATA SOURCES
 TAX LOT AND ROAD: WASCO COUNTY GIS
 SECTION LINEWORK: WASCO COUNTY GIS


PREPARED FOR
 BLAINE LIMITED PARTNERSHIP/RICHARD BLAINE
 PO BOX 450
 PARKDALE, OR 97041

Received
 FEB 20 2026
 OWRD





DATE: 02/10/2026

CLAIM OF BENEFICIAL USE MAP		EXHIBIT
BLAINE LIMITED PARTNERSHIP WATER RIGHTS		A
AKS ENGINEERING & FORESTRY, LLC 12965 SW HERMAN RD, STE 100 TUALATIN, OR 97062 503.563.6151 WWW.AKS-ENG.COM		DRWN: BCZ CHKD: SRR AKS JOB: 11833

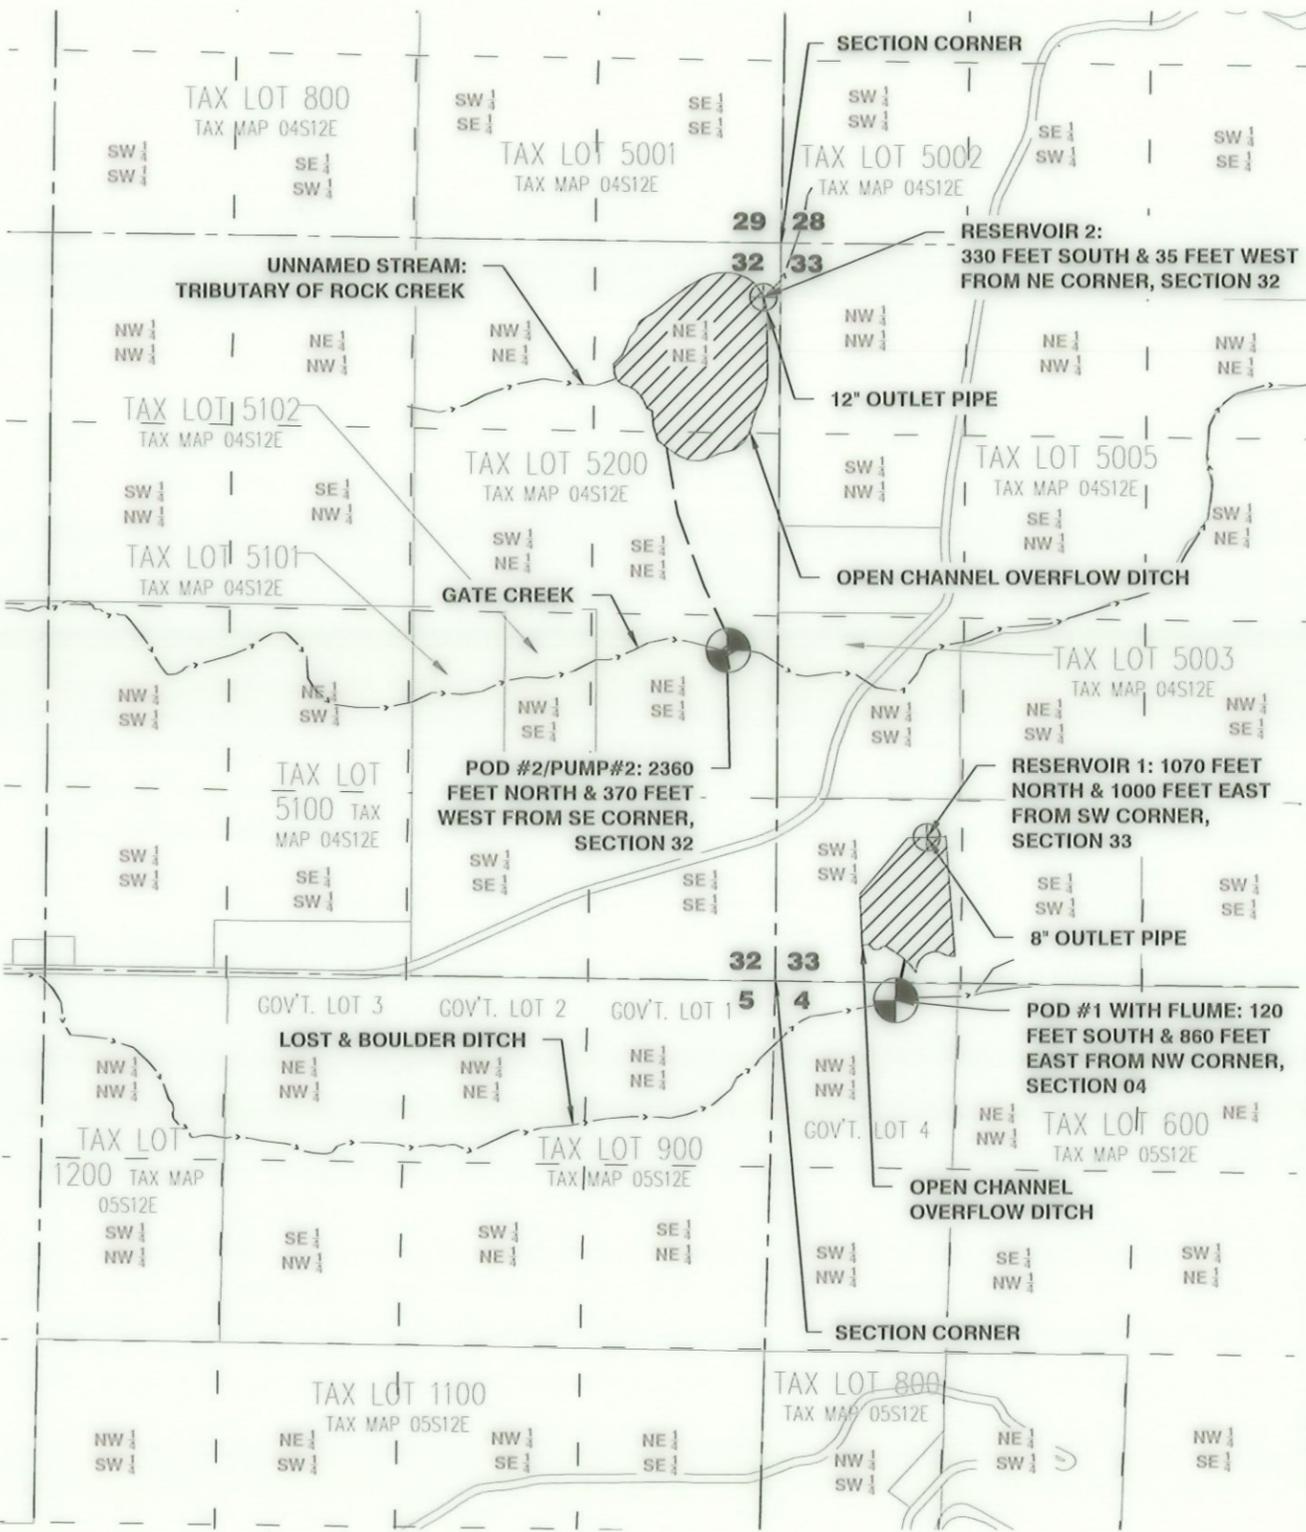

LEGEND

- POINT OF DIVERSION (POD)
- DAM LOCATION
- TAX LOT BOUNDARY
- 1/4 1/4 SECTION LINE
- SECTION LINE
- CREEK/DITCH CENTERLINE
- 6" WATER CONVEYANCE LINE
- 8" WATER CONVEYANCE LINE
- RESERVOIR #1: 80 ACRE-FEET
- RESERVOIR #2: 80 ACRE-FEET UNDER PERMIT 14868
258 ACRE-FEET UNDER PERMIT 14054

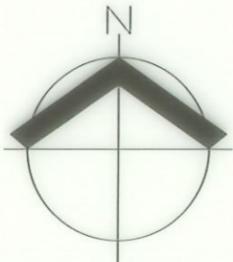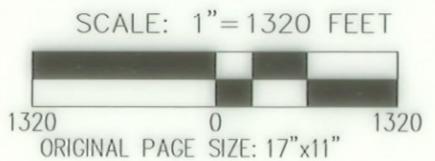

DWG: 11833 COBU_R14868 | LAYOUT