CLAIM OF BENEFICIAL USE MAP
FOR
ROBERT & TERESA SQUIRES

SECTION 26, TOWNSHIP 38 SOUTH,
RANGE 19 EAST, W.M.
LAKE COUNTY, OREGON

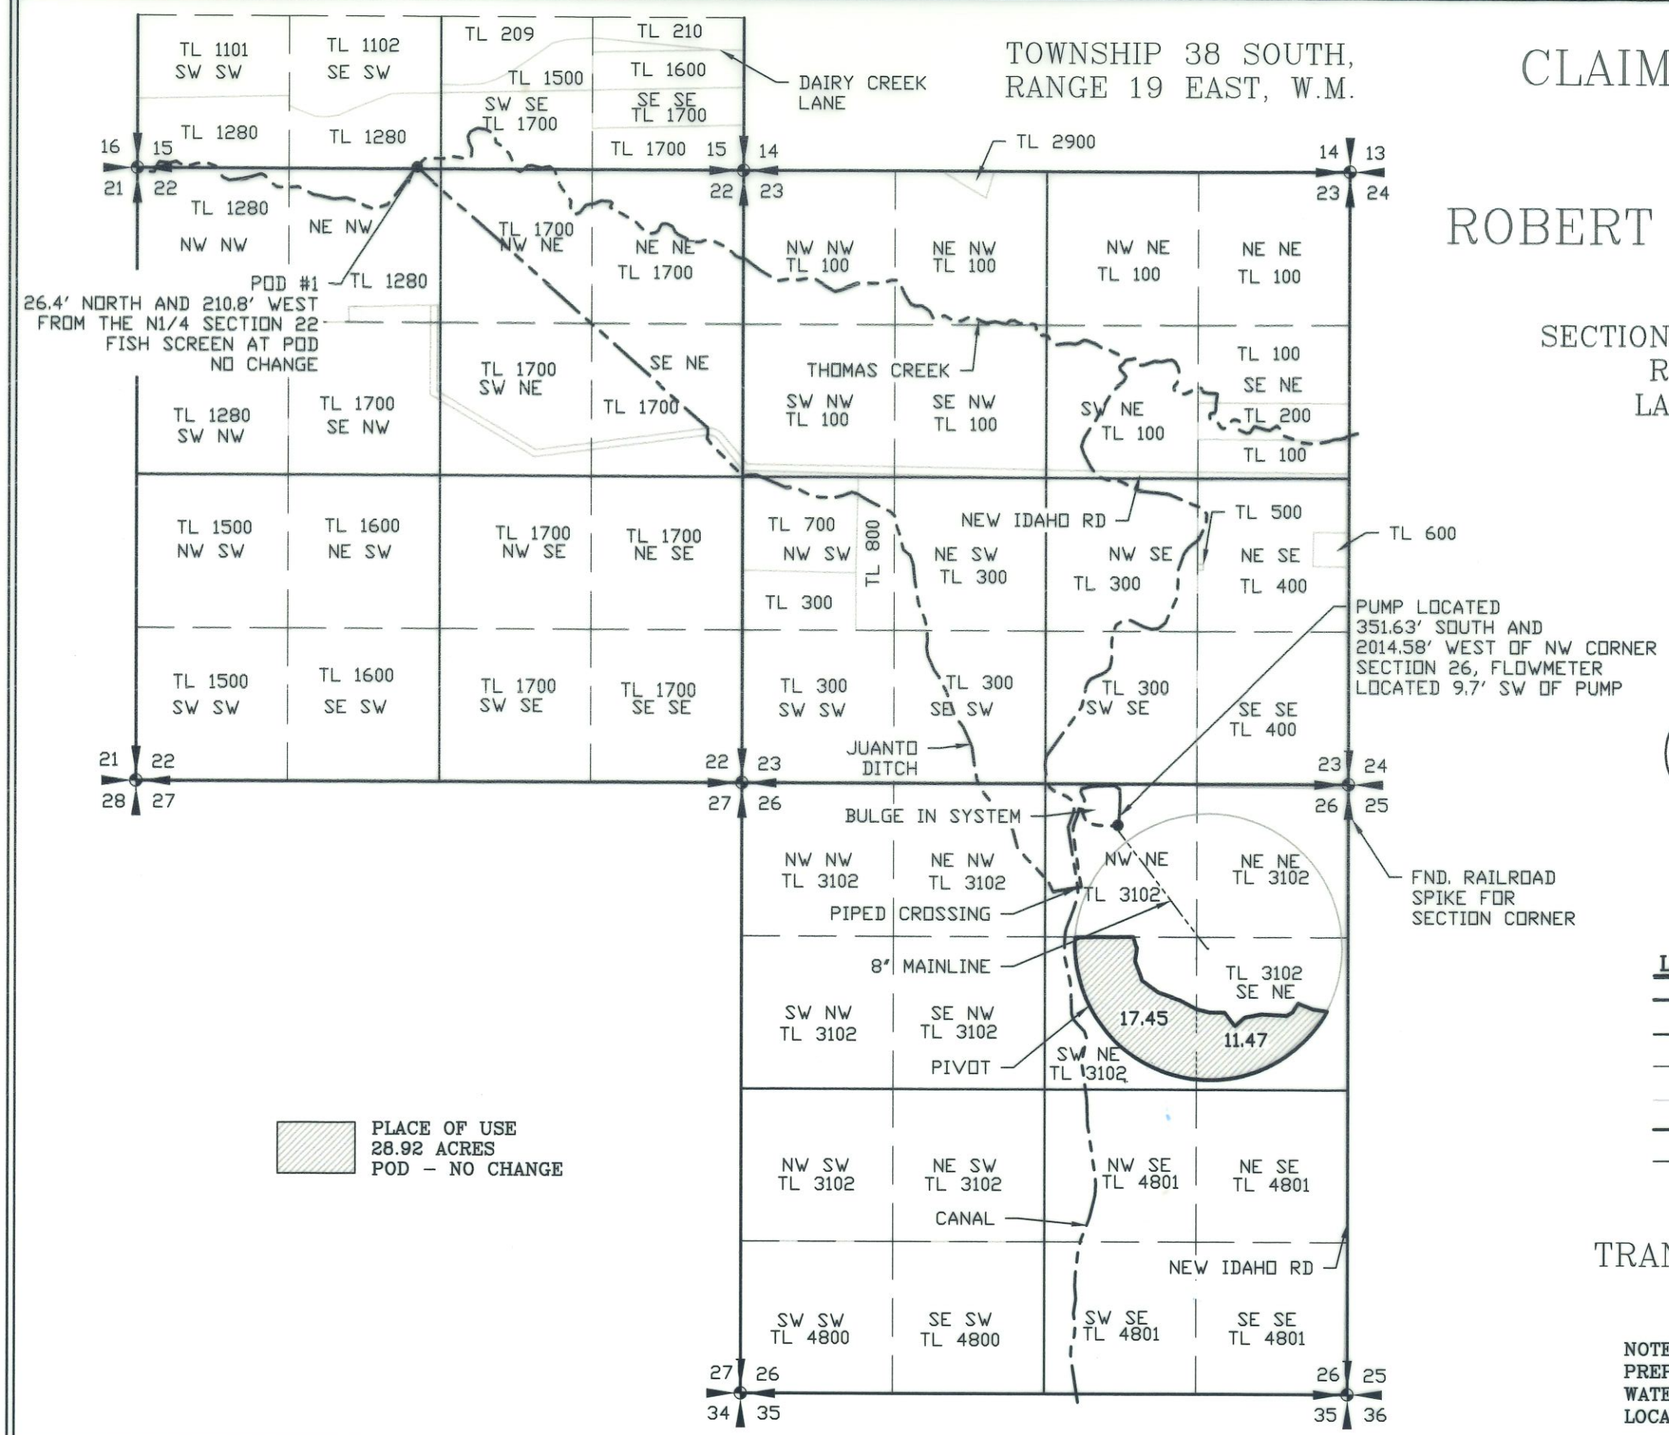

Certified Water Right Examiner
005
Darryl J. Anderson
Nov.19, 1987
STATE OF OREGON
RENEWAL 12/31/27

N
SCALE: 1"=1320'

LEGEND

- SECTION LINE
- 1/4 SECTION LINE
- 1/16 SECTION LINE
- TAXLOT LINE
- WATERWAY
- MAINLINE

Received
FEB 23 2026
OWRD

TRANSFER NO. T-13731

NOTE:
PREPARATION OF THIS MAP IS FOR IDENTIFYING PROPOSED WATER RIGHTS ONLY. IT HAS NO INTENT TO PROVIDE LOCATIONS OR DIMENSIONS OF PROPERTY BOUNDARIES.

REVISION	BY

P.O. BOX 28
LAKEVIEW, OR. 97630
WWW.SHN-ENGR.COM
541-947-4407

FOR:
ROBERT & TERESA SQUIRES
21394 NEW IDAHO RD
LAKEVIEW, OR 97630
97641

CLAIM OF BENEFICIAL USE
MAP – TRANSFER T-13731
SECTION. 26, T38S, R19E W.M.

DATE:	2/11/2026
SCALE:	1" = 1320'
DWG. BY:	R.C.
JOB:	225128
FILE:	225128
SHEET:	1 OF 1