


Claim of Beneficial Use - Red Hills Farm LLC

Application S-88918, Permit S-55318

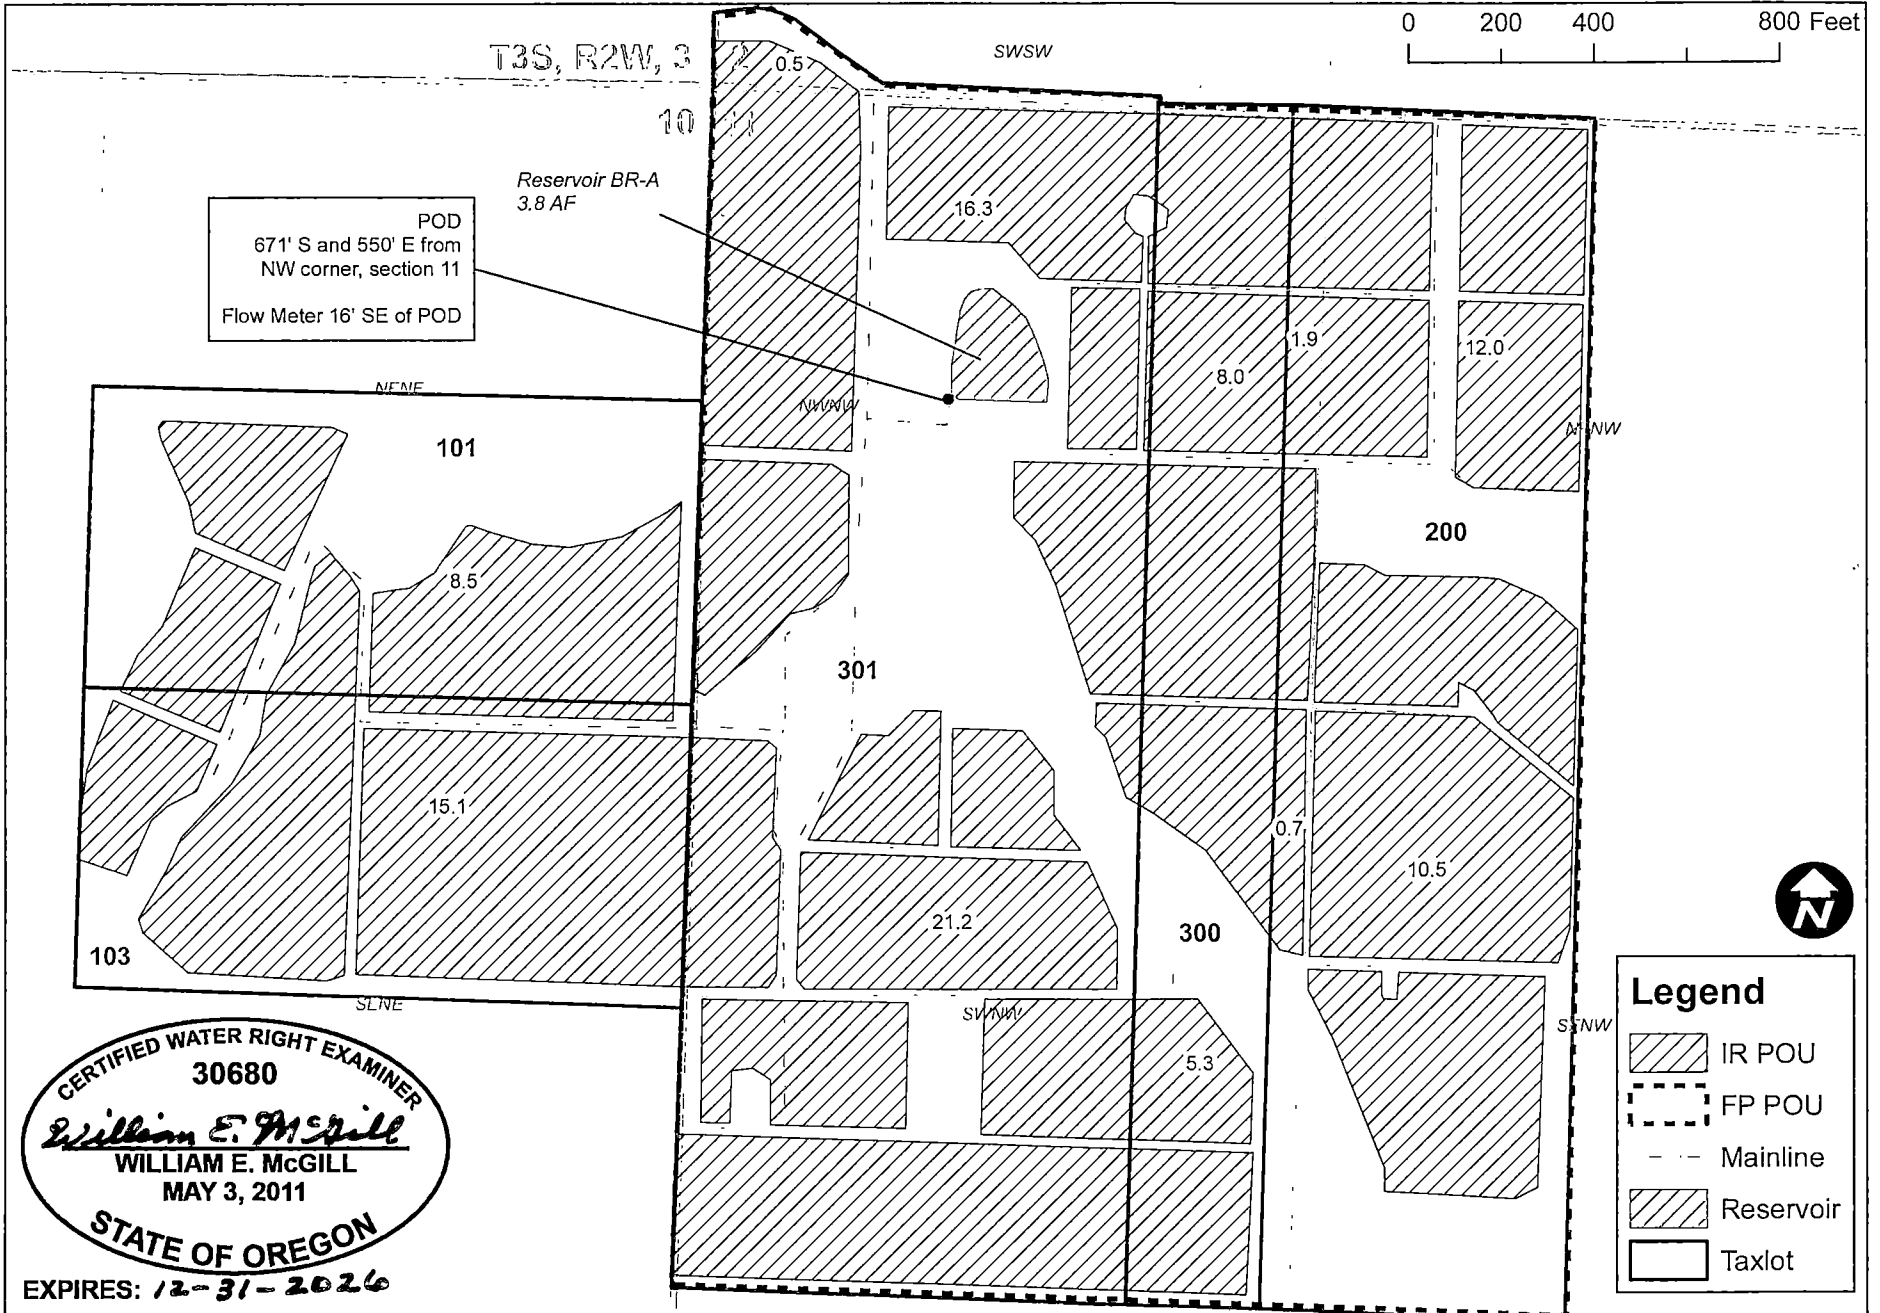

This map is not intended to provide legal dimensions or locations of property ownership lines.