


# Red Hills Farm, LLC

## Application S-88919, Permit S-55308

Township 2S, Range 3W, Section 29, W.M.

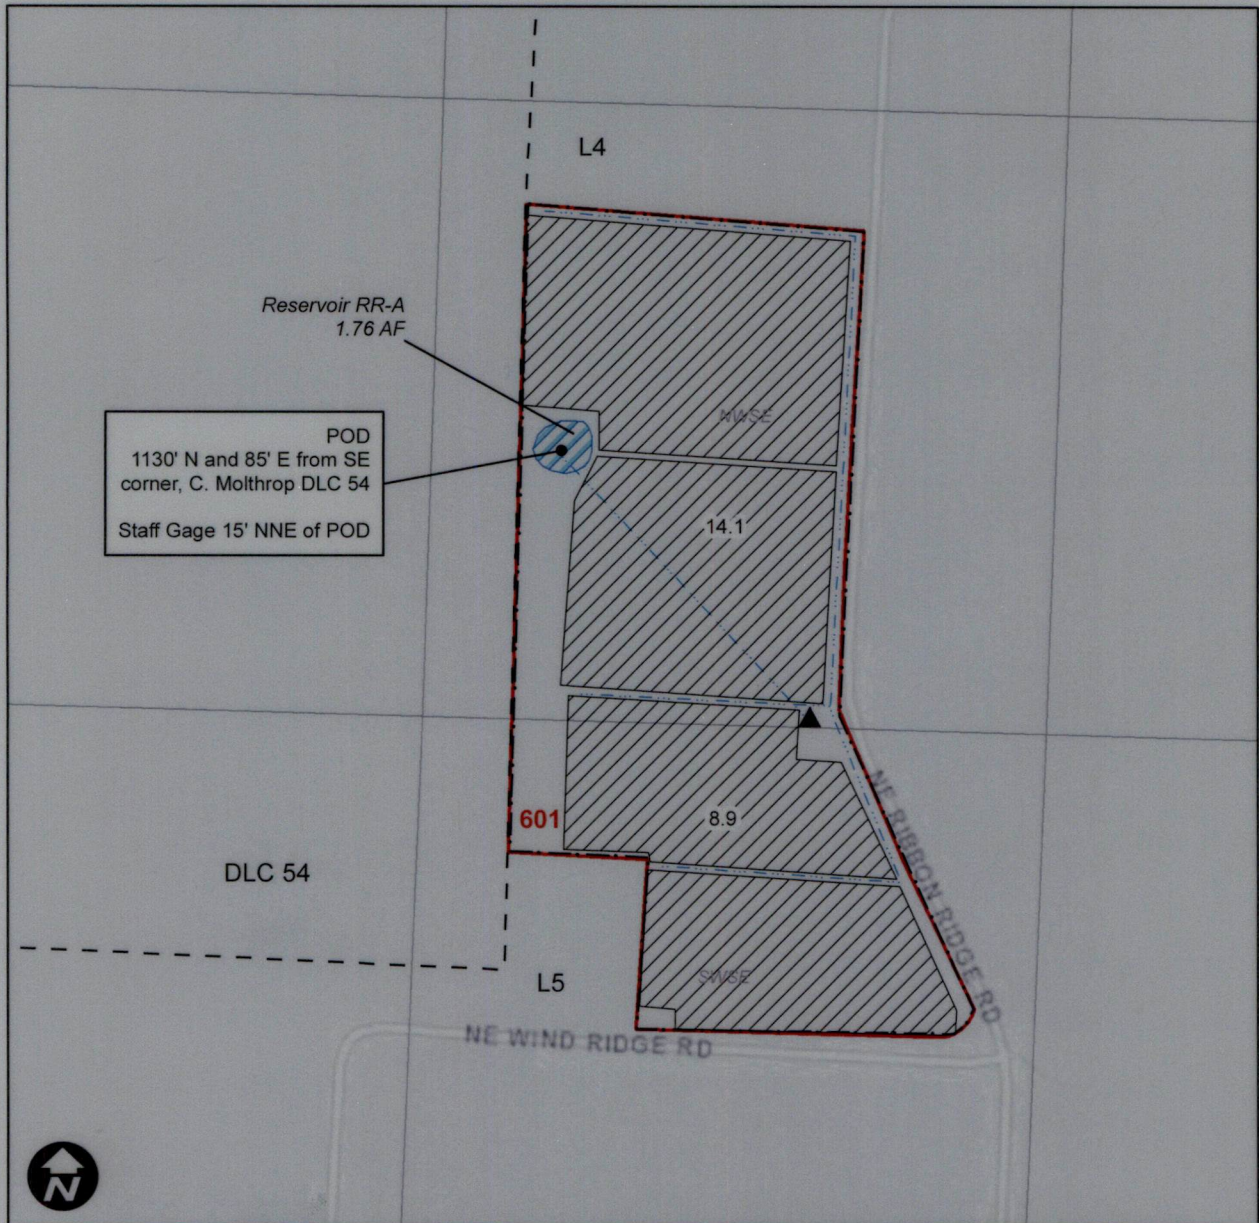

0 200 400 800 Feet

This map is not intended to provide legal dimensions or locations of property ownership lines.

### Legend

- FP POU
- Mainline
- Taxlot
- IR POU
- DLC
- Tank
- Reservoir



EXPIRES: 12-31-2026

Received by OWRD